

# SURVEY & REMONUMENTATION

LIBER 15288 PG 546

MAR 10 1995 40456

OK - T. SMITH

MAY - 1 1995

## LAND CORNER RECORDATION CERTIFICATE

Filing Requirement of Act 74, Mich. P.A. 1970

For corners in

OAKLAND

(County)

COMMISSION

Located In: WATERFORD

Corner Code =#

7.00 MISC RECORDING CHG - IN HOUSE  
2.00 REMON CHG - IN HOUSE  
10 MAR 95 4:11 P.M. RECEIPT# 1788  
PAID RECORDED - OAKLAND COUNTY  
LYNN D. ALLEN, CLERK/REGISTER OF DEEDS

Compliance with  
ACT 345, P.A. 1990

APPROVED ON: 12-30-94  
OAKLAND COUNTY REMONUMENTATION  
PEER GROUP COMMITTEE

Register of Deeds Stamp & File Number

1. Public Land Survey T 3 N R 9 E C-9  
T R  
T R  
T R
2. Property Controlling S T R  
in Section S T R
3. Miscellaneous S T R  
Property in Sec. S T R

4. Lot No. , Recorded Plat
5. Private Claims

I, THOMAS M. SMITH, in a field survey on DECEMBER 1, 19 94, do hereby certify that under requirements of P.A. 74, Michigan P.A. of 1970, the corner points mentioned in lines 1 and 2 above were in conformance with regulations and rules therefore as required in the current manual of survey instructions of the United States Department of the Interior, Bureau of Land Management or by a decree of a Court of Law and/or that the corner points mentioned in lines 3, 4 and 5 above were in conformance with the rules of the Michigan Board of Land Surveyors or by a Decree of a Court of Law; established, re-established, monumented, re-monumented, recovered, found as expressed below:


**NOTE: Not more than 4 corners, all in the same town and range, may be recorded on this certificate.**

### A. Description of original monument and accessories and/or subsequent restoration:

POST, G.L.O. 1817 BOAT SPIKE 1" IRON  
ROAD COMMISSION. L.C.R.C.  
1963. LIBER. 6381, PG. 654.  
JONES, 1974


### B. Description of corner evidence found and/or method applied in restoring or reestablishing corner:

I FOUND A 1" PIPE IN A MONUMENT BOX. I USED THE LAND CORNER CERTIFICATE RECORDED IN LIBER 6381, PAGE 654 TO RECOVER THE CORNER. ONE ROAD COMMISSION WITNESS, NW'LY TO FENCE POST WAS RECOVERED UNDERGROUND. DISTANCES MEASURED, NORTH, SOUTH, EAST, WEST MATCH CLOSELY WITH PLAT DISTANCES

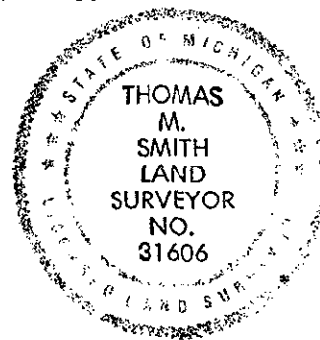

### C. Description of monument for corner and accessories established to perpetuate locating the position of the corner:

C-9: I REPLACED THE 1" PIPE WITH A 5/8" ROD WITH A BRASS CAP #31606 IN THE MONUMENT BOX.  
S 30 E, 106.35' to remon tag W. side 10" maple  
S 45 W, 89.95' to remon tag S.E. side 40" willow  
N 25 E, 114.20' to remon tag W. side 12" oak  
N 35 W, 166.97' to most E.S.E. corner of FIRE STATION.

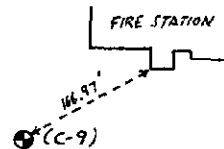

1.00  
2.00

THE SELECTED LOCATION IS ACCEPTED BY ME AND IS GENERALLY ACCEPTED BY PROFESSIONAL SURVEYORS AS THE BEST AVAILABLE EVIDENCE OF THE ORIGINAL CORNER.

Signed by

Date: DECEMBER 19 1994

Surveyor's Michigan License No. 31606