

LAND CORNER RECORDATION CERTIFICATE
Filing Requirement of Act 74, Mich. P.A. 1970

LIBER 20101 PAGE 719
\$7.00 MISC RECORDING
\$2.00 REMONUMENTATION
06/10/1999 12:32:43 P.M. RECEIPT# 41597
PAID RECORDED - OAKLAND COUNTY
G. WILLIAM CADDELL, CLERK/REGISTER OF DE

For corners in

OAKLAND

(County)

PONTIAC

Located In: TWP. Corner Code # C-9

1. Public Land Survey

T 3NR10E C-9

T R

T R

T R

2. Property Controlling in Section

S T R SURVEY & RECONSTRUCTION

3. Miscellaneous Property in Sec.

S T R

MAR 21 2000

Compliance with ACT 345, P.A. 1990

APPROVED ON: 4-21-99 JS
OAKLAND COUNTY REMONUMENTATION PEER GROUP COMMITTEE

Register of Deeds Stamp & File Number

4. Lot No. _____ Recorded Plat _____ SECTION _____

5. Private Claims _____

RAYMOND J. McCOY

May 1 99


I, _____ in a field survey on _____, 19____ do hereby state that under requirements of P.A. 74, Michigan P.A. of 1970, the corner points mentioned in lines 1 and 2 above were in conformance with regulations and rules therefore as required in the current manual of survey instructions of the United States Department of the Interior, Bureau of Land Management or by a decree of a Court of Law and /or that the corner points mentioned in lines 3, 4 and 5 above were in conformance with the rules of the Michigan Board of Land Surveyors or by a Decree of a Court of Law; established, re-established, monumented, recovered, found as expressed below:

NOTE: Not more than 2 corners, all in the same town and range, may be recorded on this certificate.

	A	B	C	D	E	F	G	H	I	J	K	L
1												
2	6		5		4		3		2		1	
3												
4	7		8		9		10		11		12	
5												
6	18		17		16		15		14		13	
7												
8	19		20		21		22		23		24	
9												
10	30		29		28		27		26		25	
11												
12	31		32		33		34		35		36	
13												

A. Description of original monument and accessories and/or subsequent restoration:

WAMPLER, D.S., SET POST
THERE ARE NO LCRC'S RECORDED.

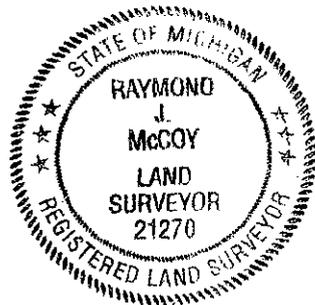

B. Description of corner evidence found and/or method applied in restoring or reestablishing corner:

Found 3" iron pipe in clay crotch along the Southerly R.O.W. line for Grand Trunk Railroad, representing a reference corner as depicted on a survey date 1926 for the State Hospital grounds. Validated corner by extending Northerly 219.66 feet on a line with the found reference corner and C-10, comparing the measured distances with the recorded distances as shown on the survey of the State Hospital, which fit very closely. Actual corner falls within the Railroad Tracks of Grand Trunk Railroad Switching Yard.

State Plane Coordinates N 419804.6833
(REFERENCE CORNER) E 13407809.9678

C. Description of monument for corner and accessories established to perpetuate locating the position of the corner:

Replaced the 3" pipe with a concrete monument consisting of a 1/2" rod encased in a 4" diameter concrete cylinder 36" long with a 2" diameter brass disk stamped Oakland County Remonumentation P.S. #21270 at the REFERENCE CORNER.

Witnesses:

N 20° E, 17.68, Southerly rail of Railroad Tracks

N 40° W, 93.39, Set OCRT #21270 in Northerly face of Power Pole

N 65° W, 21.77, set chiseled "x" in chain-linked fence post

S 75° E, 38.11, Set OCRT #21270 in Northerly face of Power pole.

THE SELECTED LOCATION IS ACCEPTED BY ME AND IS GENERALLY ACCEPTED BY PROFESSIONAL SURVEYORS AS THE BEST AVAILABLE EVIDENCE OF THE POSITION OF THE ORIGINAL CORNER.

Signed by _____

Date May 28, 1999

Surveyor's Michigan License No. 21270