

MAY 24 2000

LIBER 19616PG289

SECTION

LAND CORNER RECORDATION CERTIFICATE  
Filing Requirement of Act 74, Mich. P.A. 1970

For corners in

<u>Oakland</u> (county)	Located In:	Corner Code #
	Rose Township	
1. Public Land Survey	T4N R7E	L-3
	T R	
	T R	
	T R	
2. Property Controlling S	T R	
in Section S	T R	
3. Miscellaneous S	T R	
Property in Sec. S	T R	

\$9.00 MISC RECORDING  
\$2.00 REMONUMENTATION  
03/01/1999 02:59:15 P.M. RECEIPT# 4397  
PAID RECORDED - OAKLAND COUNTY  
G. WILLIAM CADDELL, CLERK/REGISTER OF DEEDS

Compliance with  
ACT 345, P.A. 1990

APPROVED ON: 02-03-99 JS  
OAKLAND COUNTY REMONUMENTATION  
PEER GROUP COMMITTEE

Register of Deeds Stamp & File Number

4. Lot No. , Recorded Plat

5. Private Claims

I, Joseph C. Kapelczak, in a field survey on August 5, 1998, do hereby certify that under requirements of P.A. 74, Michigan P.A. of 1970, the corner points mentioned in lines 1 and 2 above were in conformance with regulations and rules therefore as required in the current manual of survey instructions of the United States Department of the Interior, Bureau of Land Management or by a decree of a Court of Law and/or that the corner points mentioned in lines 3, 4 and 5 above were in conformance with the rules of the Michigan Board of Land Surveyors or by a Decree of a Court of Law; established, re-established, monumented, re-monumented, recovered, found as expressed below:

NOTE: Not more than 4 corners, all in the same town and range, may be recorded on this certificate.

A. Description of original monument and accessories and/or subsequent restoration:

Set post in 1816 G.L.O. Survey.

There is one LCRC recorded at Oakland County; Ward 1989. Witnesses were recovered and are shown in Section "B" of enclosed Oakland County LCRC.

B. Description of corner evidence found and/or method applied in restoring or reestablishing corner:

Recovered a 5/8" pipe at this location. This location was validated with monumentation from record survey L.16140 P.561 Ward 1996 in Section 1.

Recovered Witnesses:

\*S 14°W 103.23' nail west side 12" Tamarak (Dead)

C. Description of monument for corner and accessories established to perpetuate locating the position of the corner:

Set Oakland County Remonumentation Brass Cap stamped #24598 in top of concrete monument.

Set Witnesses:

N 62°W 379.76' Mag nail with OCRT stamped #24598 east side power pole.  
N 37°W 364.23' Mag nail with OCRT stamped #24598 west side power pole.  
N 88°W 104.38' Mag nail with OCRT stamped #24598 north side fence post.  
S 34°W 351.82' Mag nail with OCRT stamped #24598 north side 36" Oak.


\*Reused Recovered Witnesses

	A	B	C	D	E	F	G	H	I	J	K	L	N
2													
3													
4													
5													
6													
7													
8													
9													
10													
11													
12													
13													

Signed by Joseph C. Kapelczak

Date 2/3/99

Surveyor's Michigan License No. 24598

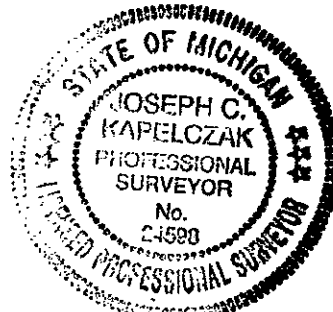

900 FILE  
200

2pk

HR-1990-8472