
 


IAY 1 6 1996	

CO	MMISSION	,
93-1010 For corners in	MMISSION LAND CORNER RECORDATION CERT	P.A. 1970 P.00 MISCELLANEOUS RECORDING CO. 1970 P.00 MISCELLANEOUS REC
Oakland (County)	Located In: Oakland Corner Code ##	29 DEC 95 9:05 A.M. RECEIPT# 45A SPAID RECORDED - CAKLAND COUNTY
Public Land Survey	T _4N R _11E T R	LYNN D. ALLEN, CLERK/REGISTER OF DEEDS Compliance with ACT 345, P.A. 1990
December Occionition	T R	APPROVED ON: 11-27-95 73 OAKLAND COUNTY REMONUMENTATION PEER GROUP COMMITTEE
2. Property Controlling in Section	S T R S T R	. pay ought committee
3. Miscellaneous Property in Sec.	STR STR	Register of Deeds Stamp & File Number

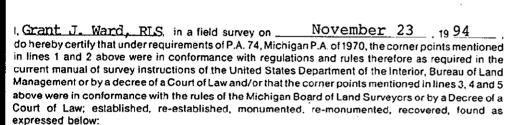

NOTE: Not more than 4 corners, all in the same town and range, may be recorded on this certificate.



D-3 Post, per G.L.O. Notes.

Private Claims

B. Description of corner evidence found and/or method applied in restoring or reestablishing corner:

Corner common to Sec. 5 and 8, T. 4 N., R. 11 E. Found 1/2" Iron Pipe 1.5' above swamp surface. Fences to the North, East and West. This corner location is a careful and faithful perpetuation of the position of the original corner.

Previously Unrecorded in Oakland County Records.

C. Description of monument for corner and accessories established to perpetuate locating the position of the corner:

Corner common to Sec. 5 and 8, T. 4 N., R. 11 E. Set Concrete Monument and Brass Cap #22445 in place of Found 1/2" Iron Pipe.

S. 63° W. s. 39° W.

Set P.K. Nail & Brass Disc #22445 in SE. face of 4" Elm.

Set P.K. Nail & Brass Disc #22445 in NW. face of 6" Maple.

Set P.K. Nail & Brass Disc #22445 in N. face of 15" Oak.

Due North

N. 71° E.

93-1010

49.31

Set P.K. Nail & Brass Disc #22445 in W. face of 6" Maple.

December 27, 1994 Date

Surveyor's Michigan Lacense No. 22445

FORM APPROVED BY MICHIGAN STATE BOARD OF LAND SURVEYORS, JAN. 28, 1971 REVISED MAY 14, 1975

REVISED JAN., 1983

GRANT J.

WARD

LAND

SURVEYOR

LAND

NOVEMBER 27, 1994

Corner Code: D-3

DOSSIER FOR: THE SOUTH 1/4 CORNER OF SECTION 5, OAKLAND TOWNSHIP, T 4 N, R 11 E, OAKLAND COUNTY, MICHIGAN. Prepared under contract with the County of Oakland Under Act 345 of the Public Acts of 1990.

HISTORY:

This Township was originally surveyed by Joseph Wampler, Deputy Surveyor, in 1817.

SPECIAL NOTES:

After reviewing the Original GLO Notes and the transcripts, I do not believe that the original survey lines were run as documented, at least in order. Inconsistencies are evidenced by the sequence of page numbers, missing pages and inserted pages from other books in the original notebook. I expect that some lines were not measured or measured in the opposite directions indicated and that a tally (330 feet) was dropped in the fourth mile from the South line of the Township. This helps to explain large discrepancies between the GLO dimensions and what we are measuring today between Corners and noted features.

This Corner has been accepted and used since before 1976, as evidenced by an un-

recorded survey.

COLLATERAL EVIDENCE:

This Corner lines up with fence lines to the North, East and West. There is a 2.5 foot wide stream 30 feet to the North and 30 feet to the West. The Corner is 53 feet North of a lake.

We searched at least 50 feet in each direction for other stakes and found none that might represent the Corner.

The measured dimensions to the Southeast Corner of Section 5 agree with the dimensions taken from recorded surveys, the most recent tax maps and/or other old surveys within half of a foot.

This Corner was reported in an unrecorded survey by Huston K. Kennedy, Surveyor, his Job No. 76-732, dated September 3, 1976.

SURVEYOR'S RECOMMENDATIONS:

Therefore, I recommend that the Peer Review Group accept this Corner as monumented, with the references as shown on the enclosed form prepared according to Act 74 of the Public Acts of 1970.

Grant J. Ward, R.L.S. License No. 22445