


STATE OF MICHIGAN  
DEPARTMENT  
OF  
NATURAL RESOURCES  
LAND CORNER RECORD

OAKLAND COUNTY  
T 4-5N R 11E


DESCRIPTION OF CORNER IRON PIN SET BY OTHERS  
CORNER MONUMENT SEC. 31 & 32 T5N-R11E & SEC 5 & 6 T4N, R11E  
DATE MONUMENT PLACED AND WITNESSED RECOVERED JAN 18, 1967  
WITNESSES TO CORNER..... N 55° W 7.5' 8" OAK

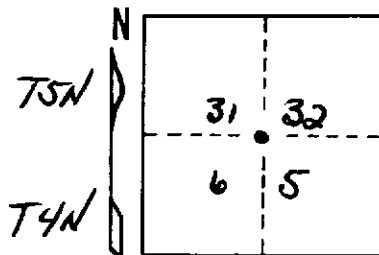

N 63° E 23.7' 6" OAK  
S 30° E 21.7' 15" OAK  
AND

CIRCLE CORNER REGISTERED

DESCRIPTION IN DETAIL AS TO HOW CORNER WAS LOCATED AND IDENTIFIED OR RESTORED.

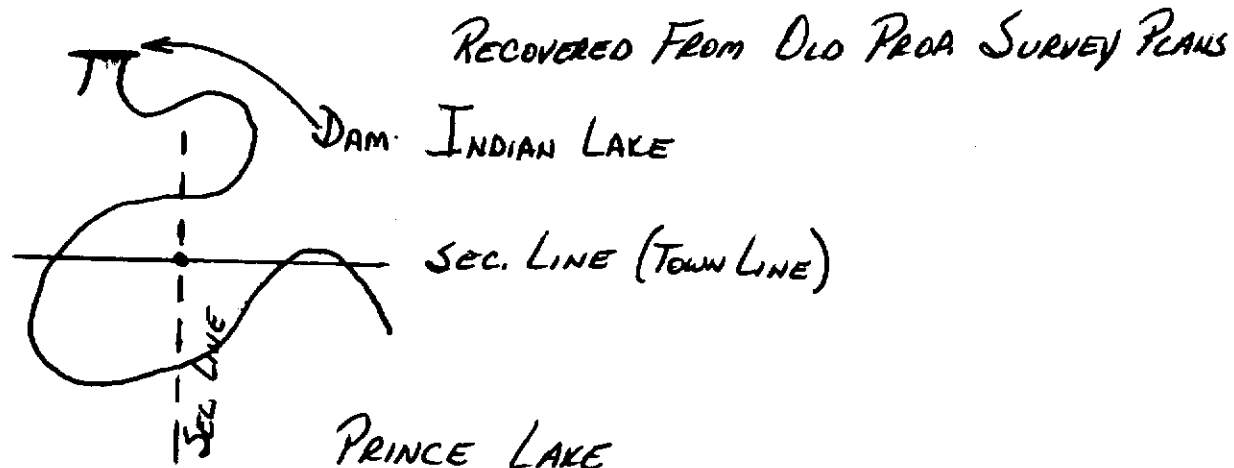

SURVEYOR'S SEAL

DISTRIBUTION:

SIGNED

[Signature]  
REGISTERED LAND SURVEYOR

DATE

County Courthouse  
Area Forester (Regions I & II)  
District or Region Surveyor  
Forestry Div., Lansing