

# SURVEY & REMONUMENTATION

MAY - 1 1995

LIBER 14833 PG 146

94 193390

## COMMISSION

## LAND CORNER RECORDATION CERTIFICATE

Filing Requirement of Act 74, Mich. P.A. 1970

Compliance with  
ACT 345, P.A. 1990

For corners in  
Oakland

(County)

Located In:

Corner Code #

5N 11E

C-5

1. Public Land Survey

T R

T R

T R

T R

2. Property Controlling  
in Section

S T R

S T R

3. Miscellaneous  
Property in Sec.

S T R

S T R

4. Lot No. , Recorded Plat

5. Private Claims

APPROVED ON: 1-19-94  
OAKLAND COUNTY REMONUMENTATION  
PEER GROUP COMMITTEE  
\$ 7.00 MISCELLANEOUS RECORDING  
\$ 2.00 REMONUMENTATION  
15 JUL 94 7:32 A.M. RECEIPT# 1A  
PAID RECORDED - OAKLAND COUNTY  
LYNN D. ALLEN, CLERK/REGISTER OF DEEDS

OK - T. SMITH

Register of Deeds Stamp & File Number

Bruce Antcliff

November 9

93

I, , in a field survey on , 19 ,  
do hereby certify that under requirements of P.A. 74, Michigan P.A. of 1970, the corner points mentioned  
in lines 1 and 2 above were in conformance with regulations and rules therefore as required in the  
current manual of survey instructions of the United States Department of the Interior, Bureau of Land  
Management or by a decree of a Court of Law and/or that the corner points mentioned in lines 3, 4 and 5  
above were in conformance with the rules of the Michigan Board of Land Surveyors or by a Decree of a  
Court of Law; established, re-established, monumented, re-monumented, recovered, found as  
expressed below:

**NOTE: Not more than 4 corners, all in the same town and range, may be recorded  
on this certificate.**

### A. Description of original monument and accessories and/or subsequent restoration:

C-5 GLO  
Post

County Witness  
15" Oak NW - 40.6'  
15" Elm SW - 87.5'  
8" Oak SE - 61.6'

E.E. Anderson & Assoc. (1978)  
N 45° E 35.0' to 12" Oak  
S 25° E 32.5' to 14" Beechnut  
N 45° W 39.5' to 24" Oak

L.C.R.C. L.8163 P. 794 (1982)  
3/4" Iron Rod  
N 45° W - 40.41' 25" Oak  
S 10° W - 37.18' 11" Oak  
N 15° E - 35.63' 8" Oak  
S 15° E - 36.14' 10" Oak

L.C.R.C. L.10341 P. 795 (1988)  
"T" iron  
N 45° E - 35.88' P.K. NW Face 17" Oak  
N 55° E - 67.95' Nail NW Face P. Pole  
S 15° E - 32.75' P.K. NE Face 17" Ash  
N 50° W - 40.37' P.K. SW Face 29" Ash

Survey: H. Kennedy (1987) & (1988)  
Same Mon & Wit as L.C.R.C. L. 10341, P. 795

### B. Description of corner evidence found and/or method applied in restoring or reestablishing corner:

C-5 Found 1/2" Iron bar in intersection of roads running N & S, E & W (Hoslinger Road and Noble Road).  
Checks the following witnesses:

County Witness  
NW - 40.6' 15" Oak

L.C.R.C. L. 8163 P. 794  
N 45° W - 40.41' 28" Oak  
N 15° E - 35.6' 8" Oak

L.C.R.C. L.10341 P. 880  
N 50° W - 40.37' P.K. SW Face 29" Ash  
N 45° E - 35.88' 17" Oak  
N 55° E - 67.95 P. Pole

E.E. Anderson & Assoc. (1978)  
N 45° W 39.5' to 24" Oak


Survey: H. Kennedy (1987) & (1988)

### C. Description of monument for corner and accessories established to perpetuate locating the position of the corner:

C-5 The selected location is accepted by the Contractor and is generally accepted by professional  
surveyors as the best available evidence of the position of the original corner.

Set 5/8" rebar with standard Oakland County cap.

P.K. Nail and Brass Tag in NE Face 28" Oak N 45° W - 39.94'  
P.K. Nail and Brass Tag in E Face 18" Oak S 25° W - 56.51'  
P.K. Nail and Brass Tag in N Face 18" Walnut S 65° E - 68.31'  
P.K. Nail and Brass Tag in NW Face P. Pole N 70° E - 67.79'

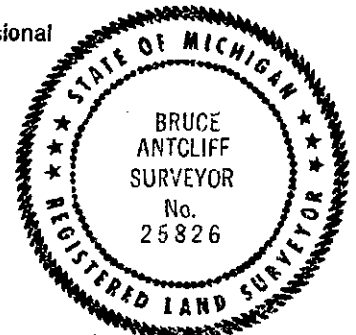

Signed by

*Bruce Antcliff*

Date

7-11-94

Surveyor's Michigan License No.

25826