

# SURVEY & REMONUMENTATION

APR 25 1995

## LAND CORNER RECORDATION CERTIFICATE Filing Requirement of Act 74, Mich. P.A. 1970

STATE OF MICHIGAN  
COUNTY OF OCEANA  
RECEIVED FOR RECORD

100560

95 JAN -4 P3:22

For Commission

OCEANA  
(County)

Located In:

Corner Code ##

*J. Randolph Hepworth*  
REGISTER OF DEEDS

1. Public Land Survey

T 16N R 17W

G-9

2. Property Controlling  
in Section

S T R

3. Miscellaneous  
Property in Sec.

S T R

4. Lot No. , Recorded Plat

5. Private Claims

Register of Deeds Stamp & File Number

I, J. Randolph Hepworth in a field survey on July 19, 1993, 19\_\_\_\_, do hereby certify that under requirements of P.A. 74, Michigan P.A. of 1970, the corner points mentioned in lines 1 and 2 above were in conformance with regulations and rules therefore as required in the current manual of survey instructions of the United States Department of the Interior, Bureau of Land Management or by a decree of a Court of Law and/or that the corner points mentioned in lines 3, 4 and 5 above were in conformance with the rules of the Michigan Board of Land Surveyors or by a Decree of a Court of Law; established, re-established, monumented, re-monumented, recovered, found as expressed below:

NOTE: Not more than 4 corners, all in the same town and range, may be recorded on this certificate.

A. Description of original monument and accessories and/or subsequent restoration:

A. G-9 CORNER COMMON TO SECTIONS 21, 22, 27, 28 T16N, R17W WEARE TOWNSHIP

GLO SET POST 24" BEECH N80°E 29.7' 11" BEECH N68°W 13.2'  
BOOK A-34 H HAWLEY, 1877 CORNER NOT DESCRIBED OR WITNESSED  
BOOK A-444 FF WETMORE, 1897 1/2"X36" IRON BY J. BEAN, 1882  
BOOK A-466 EM HYDE, 1911 FOUND STONE & IRON 20" ELM N9½°W 28.4'

OCRC WITNESS: SAME AS G BLASS, 1968

CONSUMERS POWER CO, G BLASS 1968; FOUND SPIKE OVER IRON  
NAIL/CAP T POLE N30°W 59.21 NAIL/CAP T POLE S44°W 45.95  
NAIL/CAP P POLE N22°E 84.25 NAIL/CAP FENCE POST S44°E 47.43

ACT 132, JACKET NO. 16, R. KRAFT, RLS 10064 11-8-71 Corner Not Described SHOULD BE SEC 22- INCORRECTLY LABELED SEC 22  
PP NE 84.34 STOP SIGN SW 56.7 ANCHOR POLE SW 46.1 PP NW 92.0

B. Description of corner evidence found and/or method applied in restoring or reestablishing corner

I found a 60d SPK to be a riser for a 3/4" Pipe in the centerline intersection of E-W & S pavement and gravel to North. Upon excavation, I found a 1/2" Iron 1.4' below surface; I laid a R/R spike beside it at that depth.


Measurement 1/2 mile north and east fit excellent with Hyde, 1911 survey. Further search of the area failed to yield any evidence for a conflicting position for the corner. GLO calls do not aid in determining this location.

This represents the best available evidence for the position of the corner. THE FOUND 60d SPK ABOVE 3/4" Pipe PER BLASS, 1968 AND IS ACCEPTED AS A CAREFUL AND FAITHFUL PERPETUATION OF THE POSITION OF THE ORIGINAL CORNER.

C. Description of monument for corner and accessories established to perpetuate locating the position of the corner.

G-9 CORNER COMMON TO SECTIONS 21, 22, 27, 28 T16N, R17W WEARE TOWNSHIP

SET "COUNTY SURVEYOR" HARRISON 4"X20" CAST IRON MONUMENT in place of the found 3/4" Pipe and above the 1/2" Iron  
CENTER ROAD PAYMENT E-W & N-S  
60d SPK W FACE POWER POLE/TRANSF. N25°E 82.98 TAPE  
60d SPK SW FACE Guy POLE N15°W 98.05 TAPE  
East Edge STOP SIGN S12°E 59.90 TAPE  
CENTER GAS LINE SIGN S33°W 91.50 TAPE  
60d spk NE Face 40" Willow 306°az 136.03 EDM  
60d spk NE Face 10" Spruce 285°az 141.76 EDM  
60d spk SE Face Power Pole/transf 67°az 181.09 EDM

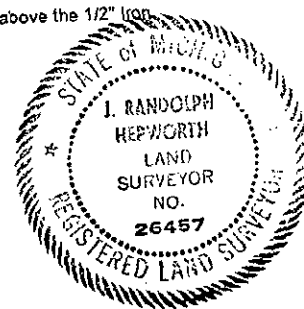

Signed by

Surveyor's Michigan License No. 26457

Date November 8, 1994

FORM APPROVED BY MICHIGAN STATE BOARD OF LAND SURVEYORS, JAN. 26, 1971  
REVISED MAY 14, 1975  
REVISED JAN., 1983