

FEB 24 2000

SECTION

LAND CORNER RECORDATION CERTIFICATE

FILING REQUIREMENT OF ACT 74, Mich. P.A. 1970

For corners in
Osceola

Located in:

Corner Code#

1. Public Land Survey

T18N	R10W	F-1
T	R	
T	R	
T	R	
2. Property Controlling s
in Section

T	R	
S	T	R
3. Miscellaneous
Property in Sec.

S	T	R
S	T	R
4. Lot No. _____ Recorded Plat _____
5. Private Claims _____

OSCEOLA COUNTY
REGISTER OF DEEDS
99 NOV 19 PM 12:10
Honey Crawford

Register of Deeds Stamp & File Number

I, Robert L. Wetherell, in a field survey on September 30, 1999, do hereby certify that under requirements of P.A. 74, Michigan P.A. of 1970, the corner points mentioned in lines 1 and 2 above were in conformance with regulations and rules therefore as required in the current manual of survey instructions of the United States Department of the Interior, Bureau of Land Management or by decree of a Court of Law and/or that the corner points mentioned in lines 3, 4, and 5 above were in conformance with the rules of the Michigan Board of Land Surveyors or by a Decree of a Court of Law; established, re-established, monumented, re-monumented, recovered, found as expressed below:

	A	B	C	D	E	F	G	H	I	J	K	L	M
1													
2	6	5	4	3	2	1							
3													
4	7	8	9	10	11	12							
5													
6	18	17	16	15	14	13							
7													
8	19	20	21	22	23	24							
9													
10	30	29	28	27	26	25							
11													
12	31	32	33	34	35	36							
13													

F-1 - N. 1/4 Corner Section 4, T18N, R10W, Osceola Co., Mi.

A. Description of original monument and accessories and/or subsequent restoration:

1977 - D. Hooth (M.D.O.T.)

L.C.R.C. - Liber 2, Pg. 96

"Found 3/8" rod, Fits old witnesses"

#1 - 14" Maple N85°E 23.87'

#2 - 3" Maple S75°E 15.89'

#3 - 8" Cherry S30°E 23.15'

#4 - 7" Poplar N78°W 17.27'

#5 - 1" x 48" Iron rod N89°56'31"W 18.34' (S. 1/4 Cor. Sec. 33, T19N, R10W)

1989 - R.L. Wetherell, LS 24624

Survey recorded Liber 511, Pg. 146

Same accessories as Hooth.

B. Description of corner evidence found and/or method applied in restoring of reestablishing corner:

I found the 3/8" rod as recorded by Hooth. Under the 3/8" rod I found a 3" clay tile with cinders. T19N, R10W was remonumented at the turn of the century (1900 m/l) with 3" clay tiles. T18N, R10W was not part of this remonumentation. The 3/8" rod with tile is the South 1/4 corner of Sec. 33, T19N, R10W and the 1" x 48" rod (actually it was an axle shaft) is the North 1/4 corner of Section 4, T18N, R10W. I measured the distance between the axle shaft and the N.E. corner of Section 4 as 2672.6 feet and to the N.W. cor. of Sec. 4 as 2580.2 feet. I accepted the axle shaft as the true North 1/4 corner of Section 4.

Condition of the accessories are as follows: #1 Found in good condition, #2 Found in good condition, #3 Found in good condition, #4 Found in good condition, #5 Found in good condition.

C. Description of monument for corner and accessories established to perpetuate locating the position of the corner:

I replaced the axle shaft with a 1" x 18" pipe with Osceola County Remon Cap. This corner not established by original government surveyors. This monument is accepted as the best available evidence of the position of the corner.

Concrete Right of Way Monument East 4.65'

5" Maple N88°W 24.16' (60d spike in S. side)

5" Maple S34°W 21.75' (60d spike in E. side)


3" Maple N01°E 12.59' (60d spike in W. side)

1" x 18" Pipe/Osceola County Cap - East 18.35' (S. 1/4 Cor. Sec. 33, T19N, R10W)

APPROVED AND CORNER
P.A. 345 OF 1990
Osceola County

10-21-99

R.L.W.

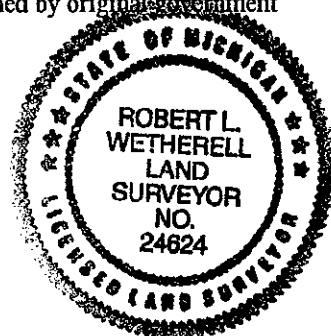

Signed by Robert L. Wetherell

Date Nov-9, 1999

Surveyor's Michigan License No. 24624