

SURVEY &
REMONUMENTATION

DEC 13 2000

SECTION LAND CORNER RECORDATION CERTIFICATE

FILING REQUIREMENT OF ACT 74, Mich. P.A. 1970

For corners in
Osceola

Located in: Corner Code#

1. Public Land Survey T 18 N R 10 W I-1
T R
T R
T R
2. Property Controlling S T R
in Section S T R
3. Miscellaneous S T R
Property in Sec. S T R
4. Lot No. Recorded Plat
5. Private Claims

OSCEOLA COUNTY
REGISTER OF DEEDS
00 MAY -5 PM 2:50
Wetherell

Register of Deeds Stamp & File Number

I, Robert L. Wetherell, in a field survey on April 3, 2000, do hereby certify that under requirements of P.A. 74, Michigan P.A. of 1970, the corner points mentioned in lines 1 and 2 above were in conformance with regulations and rules therefore as required in the current manual of survey instructions of the United States Department of the Interior, Bureau of Land Management or by decree of a Court of Law and/or that the corner points mentioned in lines 3, 4, and 5 above were in conformance with the rules of the Michigan Board of Land Surveyors or by a Decree Of a Court of Law; established, re-established, monumented, re-monumented, recovered, found as expressed below:

	A	B	C	D	E	F	G	H	I	J	K	L	M
1													
2	6	5	4	3	2	1							
3													
4	7	8	9	10	11	12							
5													
6	18	17	16	15	14	13							
7													
8	19	20	21	22	23	24							
9													
10	30	29	28	27	26	25							
11													
12	31	32	33	34	35	36							
13													

I-1 - Section corner common to Sections 2 & 3, T18N, R10W, on Twp. line

A. Description of original monument and accessories and/or subsequent restoration:

1838 - J. Hodgson, G.L.O.

#1 - 7" Beech S57°E 31 Links
#2 - 12" Hemlock S50°W 27 Links
"Intersected 23 Links West of Post".

1995 - R.L. Wetherell, LS 24624

Found ½" Rebar
#3 - 6" Maple N43°W 21.22'
#4 - 13" R. Pine N25°E 92.10'
#5 - 2" Pipe Post S55°E 3.60'
#6 - 2" Pipe Post N54°E 23.65'

B. Description of corner evidence found and/or method applied in restoring or reestablishing corner:

I found a ½" Capped Iron (LS 16929 - Erickson) 15.16' West of a 3" Clay Tile (Section corner of 34 & 35 of T19N, R10W). Corner is at the extension of the centerline of a dirt road from the South.

Condition of the accessories are as follows: #1 Gone, #2 Gone, #3 Found in good condition, #4 Found in good condition, #5 Found in good condition, #6 Found in good condition.

C. Description of monument for corner and accessories established to perpetuate locating the position of the corner:


I replaced the ½" Capped Iron with a 1" x 18" Iron Pipe with Osceola County Remon Cap, and is accepted as a careful and faithful reestablishment of the position of the original corner.

1" x 18" Pipe with Osceola Co. Cap East 15.16' (corner of Sections 34 & 35, T19N, R10W)
6" Maple N43°W 21.22' (60d spike E. side) #3
13" R. Pine N25°E 92.10' (60d spike S.E. side) #4
3" Pipe Post S55°E 3.60' (center) #5
3" Pipe Post N54°E 23.65' (center) (#6)

APPROVED LAND CORNER
P.A. 345 OF 1990
Osceola County

R. L. W.

4-20-2000

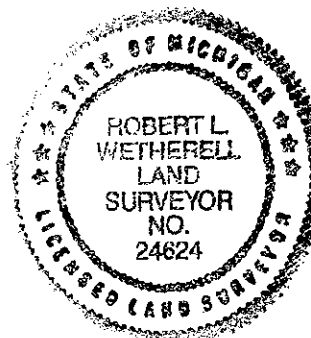

Signed by Robert L. Wetherell
Surveyor's Michigan License No. 24624

Date April 25, 2000