

DEC 18 2000

LAND CORNER RECORDATION CERTIFICATE
FILING REQUIREMENT OF ACT 74, Mich. P.A. 1970

SECTION

For corners in
Osceola

Located in: Corner Code#

1. Public Land Survey	T 20 N	R 9 W	E-3
	T	R	
	T	R	
	T	R	
2. Property Controlling in Section	S	T	R
	S	T	R
3. Miscellaneous Property in Sec.	S	T	R
	S	T	R
4. Lot No. _____ Recorded Plat _____			
5. Private Claims _____			

OSCEOLA COUNTY
REGISTERED DEEDS
00 OCT 11 AM 9:50

Register of Deeds Stamp & File Number

I, Robert L. Wetherell, in a field survey on June 5, 2000, do hereby certify that under requirements of P.A. 74, Michigan P.A. of 1970, the corner points mentioned in lines 1 and 2 above were in conformance with regulations and rules therefore as required in the current manual of survey instructions of the United States Department of the Interior, Bureau of Land Management or by decree of a Court of Law and/or that the corner points mentioned in lines 3, 4, and 5 above were in conformance with the rules of the Michigan Board of Land Surveyors or by a Decree Of a Court of Law; established, re-established, monumented, re-monumented, recovered, found as expressed below:

	A	B	C	D	E	F	G	H	I	J	K	L	M
1													
2	6	5	4	3	2	1							
3													
4	7	8	9	10	11	12							
5													
6	18	17	16	15	14	13							
7													
8	19	20	21	22	23	24							
9													
10	30	29	28	27	26	25							
11													
12	31	32	33	34	35	36							
13													

E-3 - Section corner common to Sections, 4, 5, 8 & 9, T20N, R9W

A. Description of original monument and accessories and/or subsequent restoration:

1838 - J. Hodgson, G.L.O.
#1 - 10" Hemlock N75°E 12 Links
#2 - 7" Hemlock S56°W 19 Links

1891-1904 - Temple Trumbull/June
Remonumented T20N, R9W with
3" Clay Tiles with cinders.

Undated Co. Sur. Twp. Book
Page 55.
Tile & Iron.
#4 - Pine N.E. 16.5'
#5 - Larch S.E. 36.7'
#3 - Distance North = 2634'

1888 - L. June, Co. Surveyor
"Found Government corner, one tree down".
#3 - Distance North = 2636'

B. Description of corner evidence found and/or method applied in restoring of reestablishing corner:

I found a ½" Iron in a 3" Clay Tile. Corner is in the intersection of fences North, South, East and West.
Condition of the accessories are as follows: #1 Gone, #2 Gone, #3 Did not measure, #4 Gone, #5 Gone.


C. Description of monument for corner and accessories established to perpetuate locating the position of the corner:

I replaced the ½" Iron with a 1" x 18" Pipe with Osceola Remon Cap, and is accepted as a careful and faithful reestablishment of the position of the original corner.

7" Maple S62°W 39.89' (60d spike N. side)
7" Maple N84°W 29.55' (60d spike S. side)
3" Cherry N42°E 9.62' (60d spike W. side)
3" Maple N09°W 19.31' (center)
4" Maple S52°W 7.85' (60d spike S. side)

APPROVED LAND CORNER
P.A. 345 OF 1990
Osceola County

R. L. W.
8-17-2000

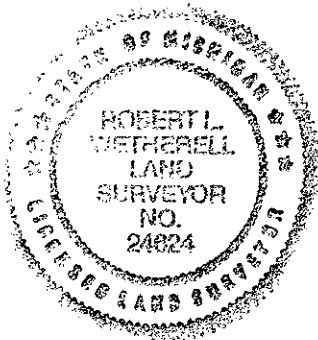

Signed by Robert L. Wetherell

Date August 22, 2000

Surveyor's Michigan License No. 24624

FORM APPROVED BY MICHIGAN STATE BOARD OF LAND SURVEYORS, JAN. 28, 1971
REVISED MAY 14, 1975
REVISED JAN. 1983
ADAPTED FOR WORD PROCESSING JANUARY, 1999