

AUG 23 1995

COMMISSION

LAND CORNER RECORDATION CERTIFICATE
Filing Requirement of Act 74, Mich. P.A. 1970

For corners in

Osceola
(County)

Located In:

Corner Code #

20N 10W

G-9

1. Public Land Survey

T R

2. Property Controlling
in Section

S T R

3. Miscellaneous
Property in Sec.

S T R

4. Lot No. , Recorded Plat

5. Private Claims

APPROVED LAND CORNER
P.A. 345 OF 1990
Osceola County

Matthew M. McClung
August 3, 1995

Register of Deeds Stamp & File Number

Matthew McClung

July 26,

95

I, in a field survey on 19 do hereby certify that under requirements of P.A. 74, Michigan P.A. of 1970, the corner points mentioned in lines 1 and 2 above were in conformance with regulations and rules therefore as required in the current manual of survey instructions of the United States Department of the Interior, Bureau of Land Management or by a decree of a Court of Law and/or that the corner points mentioned in lines 3, 4 and 5 above were in conformance with the rules of the Michigan Board of Land Surveyors or by a Decree of a Court of Law; established, re-established, monumented, re-monumented, recovered, found as expressed below:

NOTE: Not more than 4 corners, all in the same town and range, may be recorded on this certificate.

A. Description of original monument and accessories and/or subsequent restoration:

The original corner was set by deputy surveyor Sylvester Sibley on 7 July 1838. Set wood post 80 chains from South.
Beech 12" N69W 38 lks.
Hemlock 10" S51E 21 lks.

This corner is recorded in the Burdell Twp. Book, pages 32 and 33.

I have shown 1 LCRC certificate by Ray.


2. Surveys Act 132, by McClung and Erickson
B. Description of corner evidence found and/or method applied in restoring or reestablishing corner:

Found 5/8" bar at surface 20" long. Found 1 1/2" pipe 24" below surface.
Also. found 1/4" rod on NE Side of pipe, 1" above Pipe. Removed
5/8" bar and place Osceola County Monument over pipe 4" below surface.

C. Description of monument for corner and accessories established to perpetuate locating the position of the corner:

Corner G-9. Osceola County Monument, which is a 3" brass cap mounted on a 1" pipe 18" in length.
Telephone Pedestal N26W 73.99 feet.
12" White Pine N56E 70.06 feet.
8" Spruce S48W 73.36 feet.
12" White Pine S78W 124.30 feet.

OSCEOLA COUNTY
REGISTER OF DEEDS
95 AUG -9 PM12:12
Janey Crawford

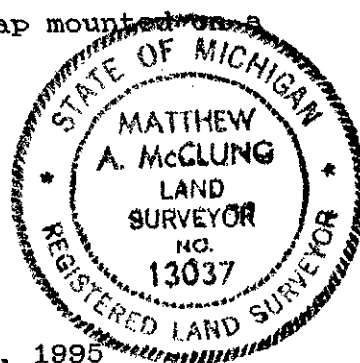

Signed by *Matthew M. McClung*

Date

July 26, 1995

Surveyor's Michigan License No. 13037

FORM APPROVED BY MICHIGAN STATE BOARD OF LAND SURVEYORS, JAN. 28, 1971
REVISED MAY 14, 1975
REVISED JAN., 1983