

SURVEY & REMONUMENTATION

MAR 19 1997

COMMISSION

LAND CORNER RECORDATION CERTIFICATE  
Filing Requirement of Act 74, Mich. P.A. 1970

For corners in  
Oscoda

(County)

Located In:

Corner Code #

1. Public Land Survey T 26N R 2E G - 1  
T R  
T R  
T R  
2. Property Controlling S T R  
in Section S T R  
3. Miscellaneous S T R  
Property in Section S T R  
4. Lot No. , Recorded Plat  
5. Private Claims

Liber 4 pg 140

STATE OF MICHIGAN  
OSCODA COUNTY  
FILED

26 NOV 96 2:54 P.M.

PATSY J. PETERS  
REGISTER OF DEEDS

Register of Deeds Stamp & File Number

I, Marvin E. Myers, in a field survey on June 27, 1996, do hereby certify that under requirements of P.A. 74, Michigan P.A. of 1970, the corner points mentioned in lines 1 and 2 above were in conformance with regulations and rules therefore as required in the current manual of survey instructions of the United States Department of the Interior, Bureau of Land Management or by a decree of a Court of Law and/or that the corner points mentioned in lines 3, 4 and 5 above were in conformance with the rules of the Michigan Board of Professional Surveyors or by a Decree of a Court of Law; established, re-established, monumented, re-monumented, recovered, found as expressed below:

NOTE: Not more than 4 corners, all in the same town and range, may be recorded on this certificate.

A. Description of original monument and accessories and/or subsequent restoration:

GLO - 1839 Coon  
Mon.-Post intersected 14 lks. West  
WIT: 14" Hemlock S49°W 44 lks.  
8" W.Birch S18°E 48 lks.

US GLO 1935 Guy Veal  
Mon.-Set 3½" brass tablet in  
conc. at intersection of road  
E-W and fence South  
WIT: 6" Maple S70°E 117½ lks.

1908 Fargo Eng.  
Mon.-Fd. gas pipe in center  
road

May 1940 G.D. Henning  
Mon.-US GLO conc.  
WIT: None given

B. Description of corner evidence found and/or method applied in restoring or reestablishing corner:


Found ½" bar in pavement box  
Standard corner East 9.20'  
And is accepted as a careful and faithful reestablishment of the position of the original corner  
Closing Corner T26N, R2E

APPROVED  
County Remonumentation  
Peer Review Group

NCC  
16 NOV 96

C. Description of monument for corner and accessories established to perpetuate locating the position of the corner:

Replaced with a Standard Oscoda Conty Monument in pav't box.  
WIT: Nail W. side utility pole N53°W 90.87'  
Nail W. side 20" Maple S38°E 115.11'  
Nail side 4" Poplar N52°E 93.70'  
Nail E. side 7" Norway S48°W 67.21'

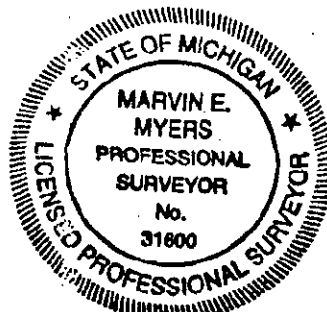

Signed by Marvin E. Myers  
Surveyor's Michigan License No. 31600

Date September 7, 1996