

LAND CORNER RECORDATION CERTIFICATE
Filing Requirement of Act 74, Mich. P.A. 1970

LIBER 3
PAGE 74

For corners in

Oscoda
(County)

Located In:

Corner Code 11

1. Public Land Survey T 27N R 1E C-9
T _____ R _____
T _____ R _____
T _____ R _____
2. Property Controlling S _____ T _____ R _____
in Section S _____ T _____ R _____
3. Miscellaneous S _____ T _____ R _____
Property in Sec. S _____ T _____ R _____

4. Lot No. _____, Recorded Plat _____
5. Private Claims _____

FILED

At 11:16 o'clock A M

Date June 6 1990

PATRICIA WRIGHT

Register of Deeds

Oscoda County, Michigan

Register of Deeds Stamp & File Number

I, Norman C. Caldwell, in a field survey on March, 19 90, do hereby certify that under requirements of P.A. 74, Michigan P.A. of 1970, the corner points mentioned in lines 1 and 2 above were in conformance with regulations and rules therefore as required in the current manual of survey instructions of the United States Department of the Interior, Bureau of Land Management or by a decree of a Court of Law and/or that the corner points mentioned in lines 3, 4 and 5 above were in conformance with the rules of the Michigan Board of Land Surveyors or by a Decree of a Court of Law; established, re-established, monumented, re-monumented, recovered, found as expressed below:

NOTE: Not more than 4 corners, all in the same town and range, may be recorded on this certificate.

A. Description of original monument and accessories and/or subsequent restoration:

(C-9) Post set by Coon, Dec. 14, 1839.
Tamarack 10" N37°W .16 (10.56')
W. Pine 9" S46°E .13 (8.58')

B. Description of corner evidence found and/or method applied in restoring or reestablishing corner:

(C-9) Original U.S. corner fnd. by C.O. Seeley, November 10, 1912,
marked NBT S05°W 32.3 14" dead Cedar
DNR mon. placed by K.J. Ostling, LS 10068, May 23, 1977, L 1, pg 178.
Henning, LS 2240, recorded in L 1, pg 170

C. Description of monument for corner and accessories established to perpetuate locating the position of the corner:

(C-9) Sec. cor 19,20,29&30, T27N-R1E

Fnd. DNR pipe & cap @ SE edge of marsh &
N. end N-S firelines. And accepted as a careful
and faithful perpetuation of the position of the
original corner.

North 1' Carsonite Witness Post

N50°E 35.2' 17" Spruce


S46°E 8.6' 12" W. Pine stump (original)

S15°W 7.2' 8" Spruce (R)

N89°E 14.2' 4" Spruce (R)

S80°E 42.2' 14" W. Pine

Signed by Norman C. Caldwell
Surveyor's Michigan License No. 12018

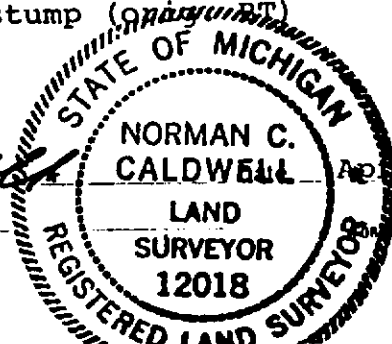

April 26, 1990

APPROVED BY MICHIGAN STATE BOARD OF LAND SURVEYORS, JAN. 28, 1977
REVISED MAY 14, 1977
REVISED JAN., 1980