

LAND CORNER RECORDATION CERTIFICATE
Filing Requirement of Act 74, Mich. P.A. 1970

For corners in
OSCODA

(County)

Located In:

Corner Code ##

- | | | |
|---------------------------------------|------------|------|
| 1. Public Land Survey | T 27N R 1E | E-9 |
| | T R | E-10 |
| | T R | E-11 |
| | T R | |
| 2. Property Controlling
in Section | S 29 T R | 3 |
| | S T R | |
| 3. Miscellaneous
Property in Sec. | S T R | |
| | S T R | |

Register of Deeds Stamp & File Number

4. Lot No. _____, Recorded Plat _____
5. Private Claims _____

I, Carl R. Johnson, in a field survey on January 29, 19 92, do hereby certify that under requirements of P.A. 74, Michigan P.A. of 1970, the corner points mentioned in lines 1 and 2 above were in conformance with regulations and rules therefore as required in the current manual of survey instructions of the United States Department of the Interior, Bureau of Land Management or by a decree of a Court of Law and/or that the corner points mentioned in lines 3, 4 and 5 above were in conformance with the rules of the Michigan Board of Land Surveyors or by a Decree of a Court of Law; established, re-established, monumented, re-monumented, recovered, found as expressed below:

NOTE: Not more than 4 corners, all in the same town and range, may be recorded on this certificate.

A. Description of original monument and accessories and/or subsequent restoration:

E-9

E-10

E-11

	A	B	C	D	E	F	G	H	I	J	K	L	M
2	6		5		4		3		2		1		
3													
4	7		8		9		10		11		12		
5													
6	18		17		16		15		14		13		
7													
8	19		20		21		22		23		24		
9													
10	30		29		28		27		26		25		
11													
12	31		32		33		34		35		36		
13													

3

B. Description of corner evidence found and/or method applied in restoring or reestablishing corner:

E-9

E-10

E-11


3

Iron pipe in place as used in previous surveys by this Department and others.

Set midway and on line between section corners. Found old fence corner approx. 18 feet WSW from this point but was not accepted as other fence lines and corners were not located correctly in this area.

Found 1/2" bar in place as established by Henning and used and accepted by this Department in a previous survey.

Set by standard survey procedure for subdivision of a section.

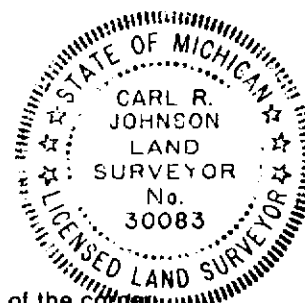

C. Description of monument for corner and accessories established to perpetuate locating the position of the corner:

E-9

E-10

E-11

3

NE cor. sec. 29
Found 3/4" Iron pipe

E 1/4 cor. sec. 29
DNR Mon.

SE cor. sec. 29
1/2" rerod

N1/8 cor. on W. line sec. 29
5/8 rerod w/cap

R. Pine 6" S84W 11.2 ft.
J. Pine 8" S22E 14.4 ft.
R. Pine 4" S67E 25.8 ft.
J. Pine 10" N34E 43.0 ft.

Maple 8" N15E 13.3 ft.
Oak 10" S12E 28.9 ft.
Oak 10" S31W 30.0 ft.
Oak 16" S76W 27.0 ft.

Maple 7" N79E 12.2 ft.
Maple 4" N20W 9.8 ft.
Fence cor. N88W 33.6 ft.
Cedar 8" S06E 31.5 ft.

Oak 6" N49E 29.8 ft.
J. Pine 10" S41E 23.9 ft.
J. Pine 10" S62W 41.3 ft.
Oak 9" N84W 22.5 ft.
Cedar post EAST 4.5 ft.

Signed by Carl R. Johnson Date 3/17/92

Surveyor's Michigan License No. 30083