

STATE OF MICHIGAN
DEPARTMENT
OF
NATURAL RESOURCES
LAND CORNER RECORD


OSCODA COUNTY
T 28 N R 1 E

DESCRIPTION OF CORNER North 1/4 corner Section 30

CORNER MONUMENT Set D.N.R. monument

DATE MONUMENT PLACED AND WITNESSED 6-26-72

WITNESSES TO CORNER..... 7" Cedar N 47 W 18.1'

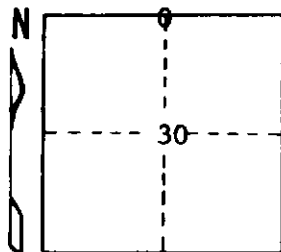


5" Cedar N 02 E 29.4'

AND

CIRCLE CORNER REGISTERED

DESCRIPTION IN DETAIL AS TO HOW CORNER WAS LOCATED AND IDENTIFIED OR RESTORED.

Set corner by proportionate measurement between section corners.

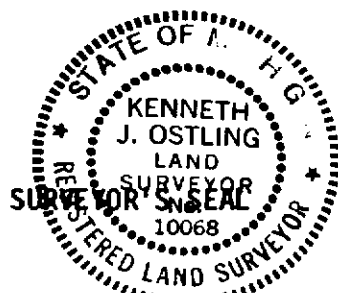

DISTRIBUTION:

SIGNED

Kenneth J. Ostling

DATE

7-3-72

REGISTERED LAND SURVEYOR 10068

Forestry Division, Lansing