

STATE OF MICHIGAN
DEPARTMENT
OF
NATURAL RESOURCES
LAND CORNER RECORD


OSCODA COUNTY
T 28 N R 3 E

DESCRIPTION OF CORNER W 1/16 S line Section 30

CORNER MONUMENT Set 2' of 1" pipe

DATE MONUMENT PLACED AND WITNESSED 5-19-72

WITNESSES TO CORNER.....

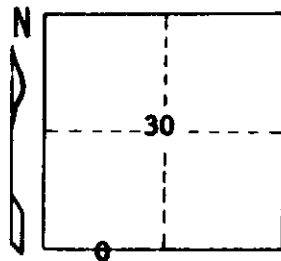

2" R. Pine S 40 E 28.6'


3" J. Pine S 45 W 13.3'

AND

CIRCLE CORNER REGISTERED

DESCRIPTION IN DETAIL AS TO HOW CORNER WAS LOCATED AND IDENTIFIED OR RESTORED.

Set corner by standard procedure for the subdivision of sections.

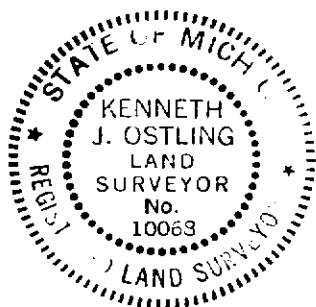

SURVEYOR'S SEAL

DISTRIBUTION:

SIGNED Kenneth J. Ostling DATE 5-26-72
REGISTERED LAND SURVEYOR
10068

Forestry Division, Lansing