

LAND CORNER RECORDATION CERTIFICATE
Filing Requirement of Act 74, Mich. PA 1970

For Corners In:

Oscoda

(County)

Located In

Corner Code #

1. Public Land Survey

T 28N R 3E E-7
T 28N R 3E C-7

2. Property Controlling
in Section

S T R
S T R

3. Miscellaneous
Property in Section

S T R
S T R

4. Lot No:


Recorded Plat:

5. Private Claims:

I, Carl T. Kiiskila, in a field survey on August 9, 2001 do hereby state that under requirements of PA 74, Michigan PA of 1970, the corner points mentioned in lines 1 and 2 above were in conformance with regulations and rules therefore as required in the current manual of survey instructions of the United States Department of the Interior, Bureau of Land Management or by a decree of a Court of Law and/or that the corner points mentioned in lines 3, 4 and 5 above were in conformance with the rules of the Michigan Board of Land Surveyors or by a Decree of a Court of Law; established, re-established, monumented, recovered, found as expressed below:

NOTE: Not more than 2 corners, all in the same town and range, may be recorded on this certificate.

Register of Deeds Stamp & File Number

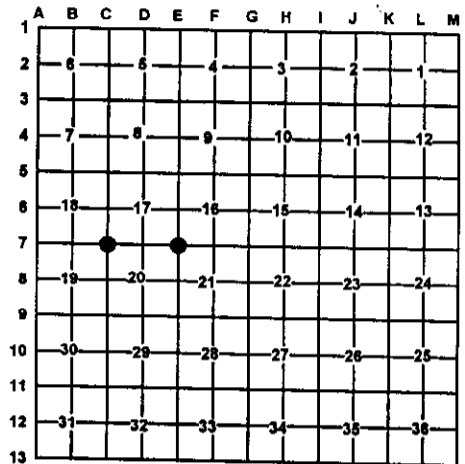

A. Description of original monument and accessories and/or subsequent restoration:

E-7 G.L.O. William R. Coon D.S. 1839

Set post corner of section 20, 21, 16, and 17

Wit: Hemlock 25 N28°W 21 links

Hemlock 12 N78°E 32 links

C-7 G.L.O. William R. Coon D.S. 1839

Set post corner of section 19, 20, 17, and 18

Wit: White Pine 20 N88.5°W 54 links

White Pine 25 N45°E 96 links

(Kenneth Ostling P.S. #10068 August 18, 1972) Set DNR monument double the distance and online with the 1/4 corner and the section corner south, fitting Seeley record measurement.

Wit: 19" Maple S10°E 71.1'

12" Soft Maple S58°E 72.8'

corner fence post south 25.5'

corner fence post S69°W 65.2'

Liber 1, Page 60 (Kenneth Ostling P.S. #10068 December 26, 1974). Set DNR monument at stake bottom concluded to be E.P. Albertson's restoration of U.S. corner in 1900. One of Albertson's witness in place.

Wit: 8" R. Pine S75°W 2.70'

6" R. Pine S80°E 12.45'

B. Description of corner evidence found and/or method applies in restoring or re-establishing corner:

E-7 Found D.N.R. monument

C-7 Found D.N.R. monument

C. Description of monument for corner and accessories established to perpetuate locating the position of the corner:

E-7 D.N.R. monument

Wit: *14" Maple S58°E 73.21'

*14"-18" Twin Maple S11°E 71.31'

Power Pole S66°W 90.14'

6" Red Pine N07°W 54.80'

CTR of E-W Gravel road North 3' ±

CTR of Gravel road South West 25' ±

C-7 D.N.R. Monument

Wit: 6" White Pine N09°W 9.23'

10" Red Pine S75°E 12.56'

7" Maple S45°E 9.35'

12" Red Pine S80°W 2.88'

Signed by:

Carl T. Kiiskila

Date:

12-3-01

Surveyor's Michigan License No.:

33981

