

SURVEY & REMONUMENTATION

OTTAWA COUNTY REMONUMENTATION

APR 24 1995

LAND CORNER RECORDATION CERTIFICATE
Filing Requirement of Act 74, Mich. P.A. 1970

RECORDED

94 DEC 14 AM 9:41

For corner COMMISSION
OTTAWA

(County)

Located In:

Corner Code #

1. Public Land Survey 5N R15W L-5 (S 1/4 cor
 T R of Sec. 12)
 T R Holland Twp.
 T R _____
2. Property Controlling S T R _____
 in Section S T R _____
3. Miscellaneous S T R _____
 Property in Sec. S T R _____

Register of Deeds Stamp & File Number

4. Lot No. _____, Recorded Plat _____
5. Private Claims _____

I, Randal J. Vugteveen, in a field survey on November 21, 19 94, do hereby certify that under requirements of P.A. 74, Michigan P.A. of 1970, the corner points mentioned in lines 1 and 2 above were in conformance with regulations and rules therefore as required in the current manual of survey instructions of the United States Department of the Interior, Bureau of Land Management or by a decree of a Court of Law and/or that the corner points mentioned in lines 3, 4 and 5 above were in conformance with the rules of the Michigan Board of Land Surveyors or by a Decree of a Court of Law, established, re-established, monumented, re-monumented, recovered, found as expressed below:

NOTE: Not more than 4 corners, all in the same town and range, may be recorded on this certificate.

A. Description of original monument and accessories and/or subsequent restoration:
L-5 common corner to Sections 12 & 13

1832 - Brookfield

Set post

Beech 10" S45W 18 Links

Beech 14" N67E 8 Links

Liber 2, Page 699

Found iron pipe & set cast iron mon.

Power Pole NW 65.00'

Light Pole SE 31.40'

SW cor house NE 100.87'

Liber 5, Page 158

NW 65.40' PK nail in NE side of P. Pole/

NNE 93.95' PK nail in W side of 10" Maple

/ NE 51.52' centerline top of fire hydrant

/ NE 100.9' SW corner foundation to house

/ SE 38.72' PK nail in SW side of P. Pole

B. Description of corner evidence found and/or method applied in restoring or reestablishing corner:

L-5 Found CIM in mon box at centerline "X" of 100th Ave. & Riley St. and accepted as a careful and faithful perpetuation of the position of the original corner

Iron pipe & cast iron mon.

P. pole NW 65.00'

SW cor house N43E 100.87'

PK nail in NE side P. pole N47W 65.40' /

PK nail in W side of 14" Maple NNE 94' /

Centerline top of fire hydrant N39E 51.51'

/ SW corner foundation to house NE 100.9'

/ PK nail in SW side of P. pole SE 38.60'

P.A. 345 OTTAWA COUNTY
PEER APPROVED 12/12/94

C. Description of monument for corner and accessories established to perpetuate locating the position of the corner:


L-5 Cast Iron Monument in mon box

Set Ottawa County Remon Tag & Nail in NE side P. pole N47W 65.40'

Set Ottawa County Remon Tag & Nail in E side L. pole S53E 38.81'

Set PK in Ottawa County Remon Tag in center of bit sidewalk S45W 50.00'

SW corner house N42E 100.87'

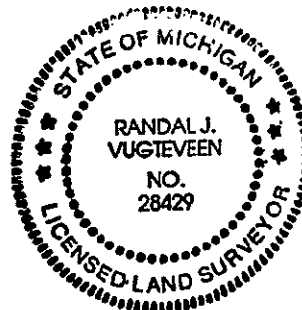

Signed by Randal J. Vugteveen

Date Dec 12, 1994

Surveyor's Michigan License No. 28429