

SURVEY & REMONUMENTATION

APR 05 1996

OTTAWA COUNTY REMONUMENTATION

COMMISSION

LAND CORNER RECORDATION CERTIFICATE Filing Requirement of Act 74, Mich. P.A. 1970

For corners in

OTTAWA

(County)

Located In:

Corner Code #

1. Public Land Survey T6N R13W F-5 (S 1/4 cor Section 9)
T R Georgetown Twp.
T R
T R
2. Property Controlling in Section S T R
3. Miscellaneous S T R
Property in Sec. S T R

RECORDED

95 NOV 15 PM 2:12

Phyllis Chellman
REGISTER OF DEEDS
OTTAWA COUNTY, MI

Register of Deeds Stamp & File Number

4. Lot No. _____, Recorded Plat _____
5. Private Claims _____

I, Randal J. Vugteveen, in a field survey on October 11, 19 95, do hereby certify that under requirements of P.A. 74, Michigan P.A. of 1970, the corner points mentioned in lines 1 and 2 above were in conformance with regulations and rules therefore as required in the current manual of survey instructions of the United States Department of the Interior, Bureau of Land Management or by a decree of a Court of Law and/or that the corner points mentioned in lines 3, 4 and 5 above were in conformance with the rules of the Michigan Board of Land Surveyors or by a Decree of a Court of Law, established, re-established, monumented, re-monumented, recovered, found as expressed below:

NOTE: Not more than 4 corners, all in the same town and range, may be recorded on this certificate.

A. Description of original monument and accessories and/or subsequent restoration:

F-5 Common corner to Sections 9 & 16

1831 - Sibley

Set post

Beech N72 W39 8 Links

Sugar N82 E41 12 Links

Liber 1, Page 743

RR spike E 3.0'

C/L pavement E 9.5'

Spike in side 24" Maple NE 86.23'

Spike in side 16" Hickory ENE 50.04'

Spike in side 22" Hickory SE 53.20'

Spike in side 16" Hickory NW 25.42'

Liber 3, Page 232

Replace 3/4" iron with cast iron mon

inscribed "Ottawa County Section Corner"

24" Maple NE 86.18'

14" Hickory ENE 50.04'

PK in fence corner W 47.30'

B. Description of corner evidence found and/or method applied in restoring or reestablishing corner:

F-5 Found Ottawa County CIM in mon box 3.0' W of centerline 28th Ave 277' N of centerline Greenmeadow Dr. and accepted as a careful and faithful perpetuation of the position of the original corner

Spike in side 24" Maple NE 86.12'

Spike in side 16" Hickory ENE 49.93'

P.A. 345 OTTAWA COUNTY

PEER APPROVED

10/23/95

Randal J. Vugteveen
YD 7

C. Description of monument for corner and accessories established to perpetuate locating the position of the corner:

F-5 Cast Iron Monument in mon box


Set Ottawa County Remon Nail & Tag in S side 18" Hickory AZ. 73 deg 49.91'

Set Ottawa County Remon Nail & Tag in SE side 28" Maple Az. 43 deg 86.14'

Set Ottawa County Remon Nail & Tag in N side p. pole Az. 270 deg 43.15'

NE foundation corner apartment building Az. 233 deg 105.73'

Top centerline hydrant Az. 166 deg 123.66'

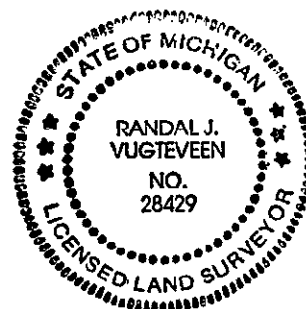

Signed by

Randal J. Vugteveen

Date

OCT. 20, 1995

Surveyor's Michigan License No.

28429

FORM APPROVED BY MICHIGAN STATE BOARD OF LAND SURVEYORS, JAN. 28, 1971
REVISED MAY 14, 1975
REVISED JAN., 1983