

SURVEY &
REMONUMENTATION

OTTAWA COUNTY REMONUMENTATION

OCT 07 1996

LAND CORNER RECORDATION CERTIFICATE
Filing Requirement of Act 74, Mich. P.A. 1970

For corners in COMMISSION

OTTAWA

(County)

Located In:

Corner Code ##

1. Public Land Survey

T 6N R 13W

K-5 (SE cor of
Sec 11)
Georgetown Twp.

2. Property Controlling
in Section

S T R

3. Miscellaneous
Property in Sec.

S T R

RECORDED

95 AUG 26 PM 2: 02

Edythe R. Holloman
REGISTER OF DEEDS
OTTAWA COUNTY, MI

Register of Deeds Stamp & File Number

4. Lot No. , Recorded Plat

5. Private Claims

I, Randal J. Vugteveen, in a field survey on November 30, 19 94,
do hereby certify that under requirements of P.A. 74, Michigan P.A. of 1970, the corner points mentioned
in lines 1 and 2 above were in conformance with regulations and rules therefore as required in the
current manual of survey instructions of the United States Department of the Interior, Bureau of Land
Management or by a decree of a Court of Law and/or that the corner points mentioned in lines 3, 4 and 5
above were in conformance with the rules of the Michigan Board of Land Surveyors or by a Decree of a
Court of Law; established, re-established, monumented, re-monumented, recovered, found as
expressed below:

**NOTE: Not more than 4 corners, all in the same town and range, may be recorded
on this certificate.**

A. Description of original monument and accessories and/or subsequent restoration:
K-5 common corner to Sections 11, 12, 13 & 14

1831 - Lyon & Sibley

Set post

W. Oak 18" N31E 53 Links

Do 14" S35W 6 Links

Liber 2, Page 205

Nly cor house foundation S 82.2'

24" Walnut W 41.54'

Liber 2, Page 433

RR spike / Nail in side P. Pole N 80.55' /

Nail in side 14" Walnut E 26.51' / Square

spike in side 20" Maple W 62.08' / C/L

Blacktop E 1.1'

B. Description of corner evidence found and/or method applied in restoring or reestablishing corner:

K-5 Found PK nail with W&W tag in bit 4' SW of centerline Cottonwood and accepted as a careful and faithful
perpetuation of the position of the original corner

Nly cor house foundation S 82.2'

24" Walnut W 41.54'

Square spike in side 20" Maple W 59.81'

Centerline blacktop E 1.1'

C/L 24" Walnut W 41.98'

C/L 24" Hickory S251/2W 55.97'

SEly cor brick porch AZ 165 95.92'

C/L 10" Maple N 60.14'

C/L 10" Maple AZ 77 46.86'

Iron in mon box N 5.80'

C. Description of monument for corner and accessories established to perpetuate locating the position of the corner:

K-5 Set 3/4 x 24" bar with Ottawa County Remonumentation Cap in mon box

Northerly corner foundation house #7987 Cottonwood AZ 180 76.41'

Set Ottawa County Remon Tag & Nail in N side 36" Black Walnut AZ 260 41.98'


Set Ottawa County Remon Tag & Nail in N side 12" Maple AZ 351 60.15'

Set Ottawa County Remon Tag & Nail in S side 12" Maple AZ 77 46.83'

P.A. 845 OTTAWA COUNTY

PEER APPROVED

12/11/95

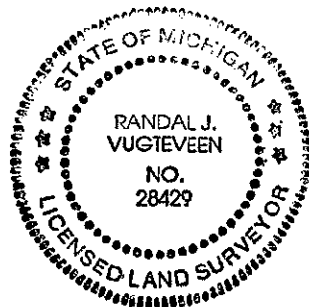

Signed by

Randal J. Vugteveen

Date

Dec 11, 1995

Surveyor's Michigan License No.

28429