

SURVEY &
REMONUMENTATION

APR 24 1995

OTTAWA COUNTY REMONUMENTATION
LAND CORNER RECORDATION CERTIFICATE

RECORDED

For corners in COMMISSION

Filing Requirement of Act 74, Mich. P.A. 1970

94 DEC 15 AM 11:45

Ottawa (County)	Located in:	Corner Code #
1. Public Land Survey	T 6N R 15W	M-7
	T R	(SE Cor., Sec.
	T R	13, Olive Twp.)
	T R	
2. Property Controlling in Section	S T R	
	S T R	
3. Miscellaneous Property in Sec.	S T R	
	S T R	
4. Lot No. _____, Recorded Plat _____		
5. Private Claims _____		

Douglas J. Koning
REGISTER OF DEEDS
OTTAWA COUNTY, MI

Register of Deeds Stamp & File Number

I, Douglas J. Koning, in a field survey on December 9, 1994, do hereby certify that under requirements of P.A. 74, Michigan P.A. of 1970, the corner points mentioned in lines 1 and 2 above were in conformance with regulations and rules therefore as required in the current manual of survey instructions of the United States Department of the Interior, Bureau of Land Management or by a decree of a Court of Law and/or that the corner points mentioned in lines 3, 4 and 5 above were in conformance with the rules of the Michigan Board of Land Surveyors or by a Decree of a Court of Law; established, re-established, monumented, re-monumented, recovered, found as expressed below:

NOTE: Not more than 4 corners, all in the same town and range, may be recorded on this certificate.

	A	B	C	D	E	F	G	H	I	J	K	L	M
2	6	5	4	3	2	1							
3													
4	7	8	9	10	11	12							
5													
6	16	17	18	15	14	13							
7													
8	19	20	21	22	23	24							
9													
10	30	29	28	27	26	25							
11													
12	31	32	33	34	35	36							
13													

A. Description of original monument and accessories and/of subsequent restoration:

M-7 Government Notes	L.C.R.C. Liber 2, Page 143 May 1973	L.C.R.C. Liber 3, Page 351 June 1979
Set Post 1832	M-7 Set Steel Bar	M-7 Found coated iron
By Lucius Lyon D.S.	Blendon Cor. N 52.80'	SW Cor. bridge 35.24'
Sylvester Sibley	Pwr. pole ESE 139.40'	Sign post N10°E 14.04'
Tamarack 4" N55°W 14 Links	Pwr. pole WSW 61.40'	Pwr. pole S20°W 61.59'
Leo 5" S22°W 43 Links	Centerline St. Sign NW 51.32'	
	Square on Conc. Hdwl. NE 49.61'	
	L.C.R.C. Liber 2, Page 707 November 1974	L.C.R.C. Liber 6, Page 167 October 1991
	M-7 Found 5/8" rubber coated iron,	M-7 Set CIM
	6' E. Centerline Road	N to Blendon Corner 52.86'
	Sign Post N10°E 14.04'	Centerline hydrant ENE 33.57'
	Pwr. pole S20°W 61.59'	Pwr. pole WSW 61.26'
	SW cor. bridge S15°W 35.24'	
	SW cor. bridge N65°E 43.10'	
	St. sign post N50°W 51.47'	

B. Description of corner evidence found and/or method applied in restoring or reestablishing corner.

M-7 Found Cast Iron Monument in Box
N. to Blendon corner 52.88'
Centerline hydrant ENE 33.54'
Found Nail N. Side P. Pole SW 61.59'

P.A. 345 OTTAWA COUNTY

PEER APPROVED


12/12/94

Kendrick D. Wedemeyer

This marker is accepted as a careful and faithful perpetuation of the original corner.

C. Description of monument for corner and accessories established to perpetuate locating the position of the corner.

M-7 Cast Iron Monument in Box (5±E of Centerline, 6'± S. of Centerline to W.)
Set O.C. Remon Nail & Tag Nly side Pwr. pole S70°W 61.59'
Set O.C. Remon Nail & Tag Nly side Pwr. pole S75°E 139.87'
Set O.C. Remon Nail & Tag Wly side 15" Maple S10°E 202.74'
Cast Iron Monument in Box N 52.88'
Top Centerline Hydrant N70°E 33.54'

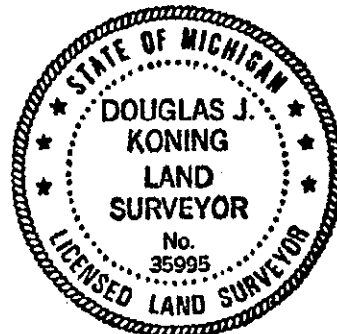

Signed by Douglas J. Koning
Surveyor's Michigan License No. 35995

Date December 12, 1994