

SURVEY & REMONUMENTATION

APR 05 1996

COMMISSION

OTTAWA COUNTY REMONUMENTATION LAND CORNER RECORDATION CERTIFICATE Filing Requirement of Act 74, Mich. P.A. 1970

For corners in

Ottawa (County)	Located In:	Corner Code ##
1. Public Land Survey	T 7N R 16W	K-2, E $\frac{1}{2}$ corner Section 2 Grand Haven Twp
	T R	
	T R	
	T R	
2. Property Controlling in Section	S T R	
	S T R	
3. Miscellaneous Property in Sec.	S T R	
	S T R	
4. Lot No. _____, Recorded Plat _____		
5. Private Claims _____		

RECORDED

95 NOV 29 PM 1:39

Register of Deeds
REGISTER OF DEEDS
OTTAWA COUNTY, MI

Register of Deeds Stamp & File Number

I, Thomas E. Joiner, in a field survey on 11/9, 19 95, do hereby certify that under requirements of P.A. 74, Michigan P.A. of 1970, the corner points mentioned in lines 1 and 2 above were in conformance with regulations and rules therefore as required in the current manual of survey instructions of the United States Department of the Interior, Bureau of Land Management or by a decree of a Court of Law and/or that the corner points mentioned in lines 3, 4 and 5 above were in conformance with the rules of the Michigan Board of Land Surveyors or by a Decree of a Court of Law; established, re-established, monumented, re-monumented, recovered, found as expressed below:

NOTE: Not more than 4 corners, all in the same town and range, may be recorded on this certificate.

A. Description of original monument and accessories and/or subsequent restoration:

05-18-1832 Liber 1, Page 395 05-11-72
Post Set By Calvin Britain, D.S. Found Pinched Pipe
S 31°E 99 10" Pine 16" Oak NW 15.6
N 12°W 39 12" Pine 14" Oak SW 29.6
17" Oak SE 42.7

Liber 4, Page 2 11-1-79
Found 1 $\frac{1}{4}$ " Bar With Pinched Pipe &
Stone Below
Q Fire Hydrant NE 42.26
Telephone Pole ESE 51.1
Power Pole SE 101.3
Q Black Oak WSW 43.37
Power Pole NW 96.8

B. Description of corner evidence found and/or method applied in restoring or reestablishing corner:

Found Cast Iron Monument (Damaged) and accepted as a careful and faithful perpetuation of the original corner.

Set Ottawa County Remon Cap Over Cast Iron Monument

Liber 4, Page 2

Q Fire Hydrant NE 42.26
Power Pole SE 101.3
Q Black Oak WSW 43.37
Power Pole NW 96.8

P.A. 345 OTTAWA COUNTY

PEER APPROVED 11/20/95


Richard D. Nedergeld
RDN

C. Description of monument for corner and accessories established to perpetuate locating the position of the corner:

Ottawa County Remon Cap Over Cast Iron Monument

Q Top Operating Bolt on Hydrant
O.C. Remon Tag & Nail in W Face Red Oak
O.C. Remon Tag & Nail in N Face Black Oak
O.C. Remon Tag & Nail in NE Face Quad 6" Oak

AZ 40° 42.26
AZ 333° 79.05
AZ 260° 44.20
AZ 150° 124.47

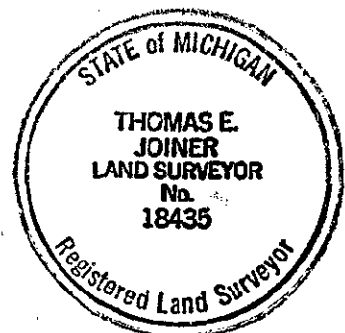

Signed by Thomas E. Joiner

Date 11-16-95

Surveyor's Michigan License No. 18435