

SURVEY & REMONUMENTATION

FEB 27 1998

SECTION

LAND CORNER RECORDATION CERTIFICATE Filing Requirement of Act 74, Mich. P.A. 1970

RECORDED

97 OCT 30 AM 10:59

For corners in

Ottawa

(County)

Located In:

Corner Code ##

1. Public Land Survey

T 7N R 16W

H-2

other
#2

T R

T R

T R

Center Section 3
Grand Haven Twp.

2. Property Controlling
in Section

S T R

S T R

3. Miscellaneous
Property in Sec.

S T R

S T R

Delia Gant

Register of Deeds
Ottawa County, MI

Register of Deeds Stamp & File Number

4. Lot No. , Recorded Plat

5. Private Claims

I, THOMAS E. JOINER in a field survey on 7-28-, 19 97, do hereby certify that under requirements of P.A. 74, Michigan P.A. of 1970, the corner points mentioned in lines 1 and 2 above were in conformance with regulations and rules therefore as required in the current manual of survey instructions of the United States Department of the Interior, Bureau of Land Management or by a decree of a Court of Law and/or that the corner points mentioned in lines 3, 4 and 5 above were in conformance with the rules of the Michigan Board of Land Surveyors or by a Decree of a Court of Law; established, re-established, monumented, re-monumented, recovered, found as expressed below:

NOTE: Not more than 4 corners, all in the same town and range, may be recorded on this certificate.

A. Description of original monument and accessories and/or subsequent restoration:

H-2 Has been reset and witnessed as part of the Ottawa County road reconstruction program and has not been approved by the Ottawa County Peer Group as the correct corner. There are currently two corners at this location
See L.C.R.C. H-2 #1

Liber 2, Page 421
11-29-97


Found concrete monument
SW 35.70 20" Maple
WSW 17.78 6" Maple
NW 37.07 30" Pine

Unable to verify corner and witnesses (see back of page)

B. Description of corner evidence found and/or method applied in restoring or reestablishing corner:

H-2 Found cast iron monument, set 36" steel bar in monument box

Liber 3, Page 163
Angle Iron S52°W 17,14

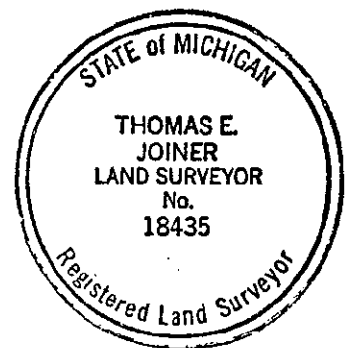

C. Description of monument for corner and accessories established to perpetuate locating the position of the corner:

H-2 36" Steel bar
36" Steel bar in monument box
Nail in S side Power Pole
Nail in SE side 7" Red Pine capped Iron
SE garage corner of house # 16405 Sleeper St.
4 feet North of centerline East West Road, on tree line to North

AZ 231° 16.89
AZ 286° 54.82
AZ 44° 41.58
AZ 30° 38.34
AZ 337° 148.64

\$ 11.00 CORNER
\$ 2.00 PHOTO

Signed by

Thomas E. Joiner
18435

Date

9-15-97

Surveyor's Michigan License No.

Part A. continued

H-2 Liber 3, Page 163
2-8-77
Set angle iron at true center
Telephone Pole S15°E 21.02
Power Pole N65°E 54.73
Angle Iron S52°W 17.14

SURVEY &
REMONUMENTATION

FEB 27 1998

SECTION