

SURVEY & REMONUMENTATION

APR 24 1995

OTTAWA COUNTY REMONUMENTATION  
LAND CORNER RECORDATION CERTIFICATE  
Filing Requirement of Act 74, Mich. P.A. 1970

RECORDED

94 DEC 15 AM 11:46

COMMISSION

For corners in

Ottawa  
(County)

Located In:

Corner Code #

1. Public Land Survey

T 8N R 16W

I-10, W 1/4 Cor.

T R

Section 26

T R

Spring Lake Twp.

T R

2. Property Controlling  
in Section

S T R

S T R

3. Miscellaneous  
Property in Sec.

S T R

S T R

*Phyllis Kullman*  
REGISTER OF DEEDS  
OTTAWA COUNTY, MI

Register of Deeds Stamp & File Number

4. Lot No. , Recorded Plat

5. Private Claims

I, THOMAS E. JOINER, in a field survey on 11-29-, 19 94, do hereby certify that under requirements of P.A. 74, Michigan P.A. of 1970, the corner points mentioned in lines 1 and 2 above were in conformance with regulations and rules therefore as required in the current manual of survey instructions of the United States Department of the Interior, Bureau of Land Management or by a decree of a Court of Law and/or that the corner points mentioned in lines 3, 4 and 5 above were in conformance with the rules of the Michigan Board of Land Surveyors or by a Decree of a Court of Law; established, re-established, monumented, re-monumented, recovered, found as expressed below:

NOTE: Not more than 4 corners, all in the same town and range, may be recorded on this certificate.

A. Description of original monument and accessories and/or subsequent restoration:

05-26-1832

Post Set by Calvin Britain, D.S.

S 19°E 25 24" Pine

N 22 1/2°W 19 5" Elm

Liber 2, Pg. 503, 03-08-74

Found Iron Pipe

SW 19.89 18" Cherry

West 40.50 30" Oak

NW 27.15 15" Oak

North 49.33 P.P.

NE 33.97 18" Maple

Liber 4, Pg. 297, 03-31-82

Set Cast Iron Monument

SE 47.57 12" Pear

NE 38.32 5" Sassafras

West 40.21 34" Oak

NW 73.78 SE Cor. Conc. Block  
Garage

B. Description of corner evidence found and/or method applied in restoring or reestablishing corner:

Found Cast Iron Monument in Monument Box and accepted as a careful and faithful perpetuation of the position of the original corner.

Liber 2, Pg. 503, 03-08-74


West 40.50 30" Oak

Liber 4, Pg. 297, 03-31-82

SE 47.57 12" Pear

NE 38.32 5" Sassafras

West 40.21 34" Oak

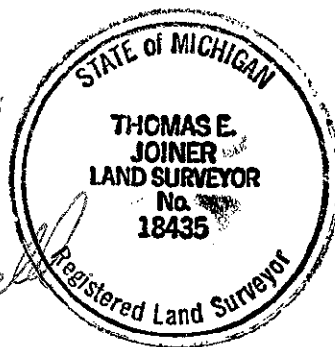

P.A. 345 OTTAWA COUNTY  
PEER APPROVED 12/12/94  
*Andrey D. Medvedev*

C. Description of monument for corner and accessories established to perpetuate locating the position of the corner:

Cast Iron Monument in Monument Box

O.C. Remon. Tag & Nail in S side 8" Sassafras

Top Operating Nut on Hydrant

NW Cor. Wood Trim Hse #15602

O.C. Remon. Tag & Nail in N side 36" Oak

O.C. Remon. Tag & Nail in S side 11" Oak

Az. 66° 38.22

Az. 88° 21.16

Az. 132° 80.69

Az. 270° 39.78

Az. 294° 38.93

Signed by

*Thomas E. Joiner*  
18435

Date

12-12-94

Surveyor's Michigan License No.