

LAND CORNER RECORDATION CERTIFICATE
Filing Requirement of Act 74, Mich. P.A. 1970

For corners in

ONTONAGON
(County)

Located In: Corner Code #

1. Public Land Survey T48N R39W I-10
T R
T R
T R

2. Property Controlling S T R
in Section S T R

3. Miscellaneous S T R
Property in Sec. S T R

REMO

OCT 8 9 1997

COMMISSION

Register of Deeds Stamp & File Number

4. Lot No. Recorded Plat
5. Private Claims

$\frac{1}{4}$ Corner common to Sections 26 & 27, T48N R39W.

I, Earl W. Applekamp, in a field survey on June 21, 1997 do hereby state that under requirements of P.A. 74, Michigan P.A. of 1970, the corner points mentioned in lines 1 and 2 above were in conformance with regulations and rules therefore as required in the current manual of survey instructions of the United States Department of the Interior, Bureau of Land Management or by a decree of a Court of Law and/or that the corner points mentioned in lines 3, 4 and 5 above were in conformance with the rules of the Michigan Board of Land Surveyors or by a Decree of a Court of Law; established, re-established, monumented, recovered, found as expressed below:

NOTE: Not more than 2 corners, all in the same town and range, may be recorded on this certificate.

	A	B	C	D	E	F	G	H	I	J	K	L	M
1													
2		6		5		4		3		2		1	
3													
4		7		8		9		10		11		12	
5													
6		18		17		16		15		14		13	
7													
8		19		20		21		22		23		24	
9													
10		30		29		28		27		26		25	
11													
12		31		32		33		34		35		36	
13													

A. Description of original monument and accessories and/or subsequent restoration:

Original corner established by Artemas Curtis, U.S. Deputy Surveyor, September 1851. Set Wood Post.

ORIGINAL BEARING TREES:

14" Hemlock N65°W 11.22 feet
16" Hemlock S70°E 11.22 feet

B. Description of corner evidence found and/or method applied in restoring or reestablishing corner:

No original evidence was found. Corner position falls in a county blacktop road running North and South. Extensive farming is being performed East and West. There is some evidence of a hedge row running East from the apparent corner position. Corner was re-established by single proportionate measure to corners North & South and in the centerline of the blacktop road.


Research on file with the Ontonagon County Remonumentation Program Representative.

C. Description of monument for corner and accessories established to perpetuate locating the position of the corner:

At the corner position I set a 5/8"X8" rebar with a 3" stamped cap 2" below top of blacktop. I established a reference monument, a 2 1/2"X30" aluminum pipe with a 3" cap stamped to read: County Remonumentation, T48N R39W, R.M., $\frac{1}{4}$, S26, S27, 1997, P.S. 17610. I also established only two other reference objects as the area is all fields.

REF. MON. N55°-25'-11"E 35.22' - Nail in Power Pole S20°-37'-48"W 62.44'
Steel Sign Post N55°E 36.4' - Nail in Power Pole N13°-22'-04"W 92.37'

PEER GROUP APPROVED
Earl W. Applekamp
COUNTY REPRESENTATIVE
7-15-97

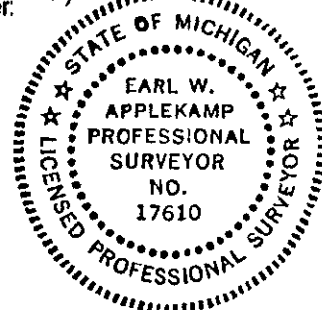

Signed by Earl W. Applekamp
Surveyor's Michigan License No. 17610

Date June 25, 1997