

SURVEY & REMONUMENTATION

APR 29 1996

COMMISSION

JUDITH D. ROEHM
Ontonagon County
LC 3/329 JEM

09/28/95

14:38

Fee: 9.00
Page 1 of 1

LAND CORNER RECORDATION CERTIFICATE Filing Requirement of Act 74, Mich. P.A. 1970

For corners in

_____	Ontonagon (County)	Located In:	Corner Code ##
1. Public Land Survey	T 48N R 42W		
	T _____ R _____		
	T _____ R _____		
	OTHER T <u>48N</u> R <u>42W</u>		<u>#009 pm</u>
2. Property Controlling in Section	S _____ T _____ R _____		
	S _____ T _____ R _____		
3. Miscellaneous Property in Sec.	S _____ T _____ R _____		
	S _____ T _____ R _____		

Register of Deeds Stamp & File Number

4. Lot No. _____, Recorded Plat _____
5. Private Claims _____
Meander corner common to Sections 7 and 8, T48N, R42W

I, John R. Garske, in a field survey on September 7, 19 95,
do hereby certify that under requirements of P.A. 74, Michigan P.A. of 1970, the corner points mentioned
in lines 1 and 2 above were in conformance with regulations and rules therefore as required in the
current manual of survey instructions of the United States Department of the Interior, Bureau of Land
Management or by a decree of a Court of Law and/or that the corner points mentioned in lines 3, 4 and 5
above were in conformance with the rules of the Michigan Board of Land Surveyors or by a Decree of a
Court of Law; established, re-established, monumented, re-monumented, recovered, found as
expressed below:

**NOTE: Not more than 4 corners, all in the same town and range, may be recorded
on this certificate.**

A. Description of original monument and accessories and/or subsequent restoration:

- On August 10, 1848, Austin Burt set a cedar post from which a 10" cedar bears S87°E, 18 links and a 12" cedar - N44°W, 17 links.
- On September 1, 1995, Coleman Engineering Company found a 1/2" iron rod with a cap at the corner position as pointed out to us by Earl Applekamp, RLS 17610.

B. Description of corner evidence found and/or method applied in restoring or reestablishing corner:

Found a 1/2" diameter iron rod as described above. Accepted the corner position as true as it checks with occupation lines and lies in harmony with local residences and has been used in several surveys of record.

Record research on file with Register of Deeds.

PEER GROUP APPROVED

Earl Applekamp 9-20-95
COUNTY REPRESENTATIVE

C. Description of monument for corner and accessories established to perpetuate locating the position of the corner:


I replaced the found 1/2" iron rod with a 2 1/2" diameter x 30" long with a 3 1/4" diameter aluminum cap stamped: County Remonumentation; T48N; R42W; M.C.; S-7; S-8; 1995; RLS 28410, from which I established the following bearing trees and/or reference objects:

- 4" ash - N26°E - 11.95 feet
- 7" cedar - S21°E - 22.92 feet
- 4" ash - S79°W - 5.71 feet
- 6 foot steel rail with sign - Due North - 2.00 feet

Signed by John R. Garske
Surveyor's Michigan License No. 28410

Date

9-19-95

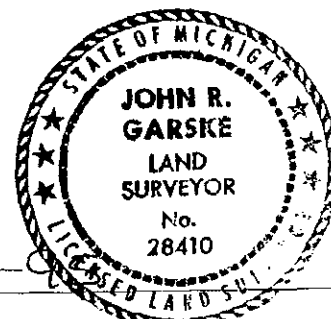

FORM APPROVED BY MICHIGAN STATE BOARD OF LAND SURVEYORS, JAN. 28, 1971
REVISED MAY 14, 1975
REVISED JAN., 1983

FED No. G-H-5 329