

REMONUMENTATION

LAND CORNER RECORDATION CERTIFICATE OCT 8 1997
Filing Requirement of Act 74, Mich. P.A. 1970

For corners in

Ontonagon Located in: _____ Corner Code # _____
(County)

1. Public Land Survey T 51N R 40W D-5
T _____ R _____
T _____ R _____
T _____ R _____

2. Property Controlling S _____ T _____ R _____
in Section S _____ T _____ R _____

3. Miscellaneous S _____ T _____ R _____
Property in Sec. S _____ T _____ R _____

COMMISSION

JUDITH D. ROEHM 06/13/97
Ontonagon County 15:35
LC 4/290 JDT Feet 9.00
Page 1 of 1

Register of Deeds Stamp & File Number

4. Lot No. _____, Recorded Plat _____
5. Private Claims _____

I, Joseph C. Domitrovich, in a field survey on June 6, 19 97 do hereby state that under requirements of P.A. 74, Michigan P.A. of 1970, the corner points mentioned in lines 1 and 2 above were in conformance with regulations and rules therefore as required in the current manual of survey instructions of the United States Department of the Interior, Bureau of Land Management or by a decree of a Court of Law and/or that the corner points mentioned in lines 3, 4 and 5 above were in conformance with the rules of the Michigan Board of Land Surveyors or by a Decree of a Court of Law; established, re-established, monumented, recovered, found as expressed below:

NOTE: Not more than 2 corners, all in the same town and range, may be recorded on this certificate.

(D-5) 1/4 Corner Common to Sections 8 and 17, T 51N, R40W

A. Description of original monument and accessories and/or subsequent restoration:

1845 - William A. Burt, D.S., set fir post.
10" Cedar N 30° E 29 links
14" Cedar N 74° W 28 links

B. Description of corner evidence found and/or method applied in restoring or reestablishing corner:

Original corner and accessories have been destroyed by construction of North-South Quarterline Road. I re-established corner position at the intersection of an old fenceline that runs to the West and on the extension of distant centerline of Quarterline Road. I also found the broken off remains of a 1 1/4" iron pipe lying flat at this position. It works well with occupation of a one acre parcel to the West. Corner falls 4' West of Quarterline Road at this point and 13' South of a containment fence to the East.


Research on file with County Remonumentation Representative.

C. Description of monument for corner and accessories established to perpetuate locating the position of the corner:

Corner is a 5/8" x 24" iron pin with a 3" diameter aluminum cap stamped: COUNTY REMONUMENTATION; T.51N, R.40W; 1/4; S. 8, S. 17; 1997; P.S. 37273. I also placed a Reference Monument (R.M.) to the East, a 2" x 30" aluminum pipe with a 3" diameter aluminum cap stamped to indicate that the corner is West 32.99'.

7" Twin Yellow Birch S 73° E 26.00'
12" Soft Maple S 60° W 28.73'
8" Poplar N 52° E 32.35'
Reference Monument N 89° 24' 15" E 32.99'
SE Corner Sec. 8 N 89° 46' 22" E 2612.46'
SW Corner Sec. 8 S 89° 40' 46" W 2648.88'

PEER GROUP APPROVED
Phil W. Appeltkamp
COUNTY REPRESENTATIVE
6-10-97

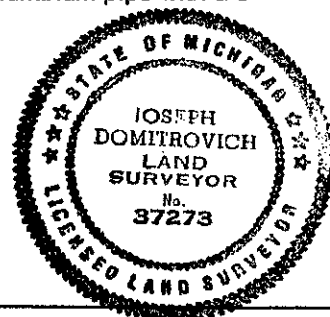

NOTE: Bearings are magnetic. Distances are to nail in side of witness objects unless noted.

Signed by Joseph C. Domitrovich Date 6/9/97
Surveyor's Michigan License No. 37273