

LAND CORNER RECORDATION CERTIFICATE
Filing Requirement of Act 74, Mich. P.A. 1970

For corners in Ontonagon Located In: Corner Code #
(County)

1. Public Land Survey T 52N R 40W E/F-13 005
T 51N R 40W E/F-4 (004)
T _____ R _____
T _____ R _____
2. Property Controlling S _____ T _____ R _____
in Section S _____ T _____ R _____
3. Miscellaneous S _____ T _____ R _____
Property in Section S _____ T _____ R _____
4. Lot No. _____, Recorded Plat _____
5. Private Claims _____

SURVEY &
REMONUMENTATION

MAY 22 1997

COMMISSION

Register of Deeds Stamp & File Number

I, Joseph C. Domitrovich, in a field survey on September 26, 19 96, do hereby certify that under requirements of P.A. 74, Michigan P.A. of 1970, the corner points mentioned in lines 1 and 2 above were in conformance with regulations and rules therefore as required in the current manual of survey instructions of the United States Department of the Interior, Bureau of Land Management or by a decree of a Court of Law and/or that the corner points mentioned in lines 3, 4 and 5 above were in conformance with the rules of the Michigan Board of Professional Surveyors or by a Decree of a Court of Law; established, re-established, monumented, re-monumented, recovered, found as expressed below:

NOTE: Not more than 4 corners, all in the same town and range, may be recorded on this certificate.

A. Description of original monument and accessories and/or subsequent restoration:

(E/F-13) Meander Corner Common to Section 33, T52N R40W, and Section 4, T51N R40W

1845 - William A. Burt intersected Lake Superior at 60.32 chains (1341.12') West of the 1/4 Corner and set post
12" Hemlock S 08° W 27 links

1952 - Victor A. Arcand, R.L.S. 10678, in survey for "Mary M. Craig, Potato River Property" (partial copy of survey at Ontonagon County Equalization), placed drill steels on section line at 303.7', 420.80', 537.9', 889.20, and 1006.30' West of a drill steel at the "South 1/4 Corner of Section 33".

B. Description of corner evidence found and/or method applied in restoring or reestablishing corner:

The original Meander Corner and accessories have been destroyed by extreme shoreline erosion. I recovered the drill steel that Arcand called the South 1/4 Corner of Section 33.

I determined this corner to be the North 1/4 Corner of Section 4, T51N, R40W after extensive retracement in sections to the South. I also recovered drill steels at the following distances West of the Arcand 1/4 Corner: 302.32', 418.64', 535.54', and 886.12'. The drill steels line up well with one another. I used the drill steels to re-establish the Section line and established a Witness Corner to the Meander Corner on this line, 483.54' East of GLO Meander Corner position. Original Meander Corner falls in Lake Superior.

Research on file with County Remonumentation Representative.

C. Description of monument for corner and accessories established to perpetuate locating the position of the corner:

Corner is a 2" x 30" aluminum pipe with a 3" diameter aluminum cap stamped to read: W.C.M.C.; S: 4, S. 33; T.52N, T.51N, R.40W; 1996; P.S. 37273; COUNTY REMONUMENTATION. Corner falls 96' East of shore of Lake Superior


Witnesses:

1" Drill Steel	S 87° 26' 36" E	39.12'
N1/4 Cor. Sec. 4	S 87° 26' 36" E	925.24'
T 51N, R40W		
8" Twin Maple	S 70° E	32.37'
8" Twin Maple	S 07° E	31.38'
8" Soft Maple	S 10° W	3.46'
Steel Sign Post	West	0.98'

NOTE: Bearings are magnetic. Distances are to nail in side of witness objects unless noted.

PEER GROUP APPROVED

COUNTY REPRESENTATIVE

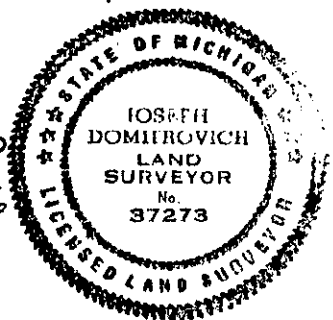

Signed by Joseph C. Domitrovich

Date 11/10/96

Surveyor's Michigan License No. 37273