

LAND CORNER RECORDATION CERTIFICATE
Filing Requirement of Act 74, Mich. P.A. 1970

Ontonagon County

Page 1 of 1

LC 5/256

JEN Date 11/23/1999

Time 18:40:05

RECORDING FEE:

9.00

For corners in

Ontonagon County Located in: Corner Code #

- 1. Public Land Survey T51N R40W M-6/7 **010**
T51N R39W A-6/7
- 2. Property Controlling S T R
in Section S T R
- 3. Miscellaneous S T R
Property in Sec. S T R
- 4. Lot No. , Recorded Plat
- 5. Private Claims

SURVEY &
REMONUMENTATION

MAR 23 2000

SECTION

Register of Deeds Stamp & File Number

A	B	C	D	E	F	G	H	I	J	K	L	M
1												
2	6	5	4	3	2	1						
3												
4	7	8	9	10	11	12						
5												
6	18	17	16	15	14	13						
7												
8	19	20	21	22	23	24						
9												
10	30	29	28	27	26	25						
11												
12	31	32	33	34	35	36						
13												

I, Joseph C. Domitrovich, in a field survey on November 3, 1999, do hereby state that under requirements of P.A. 74, Michigan P.A. of 1970, the corner points mentioned in lines 1 and 2 above were in conformance with regulations and rules therefore as required in the current manual of survey instructions of the United States Department of the Interior, Bureau of Land Management or by a decree of a Court of Law and for that the corner points mentioned in lines 3, 4 and 5 above were in conformance with the rules of the Michigan Board of Land Surveyors or by a Decree of a Court of Law; established, re-established, monumented, recovered, found as expressed below:

NOTE: Not more than 2 corners, all in the same town and range, may be recorded on this certificate.

A. Description of original monument and accessories and/or subsequent restoration:

(M-6/7 & A-6/7) Meander Corner on Left Bank of the Ontonagon River between Sections 13, T51N, R40W and 18, T51N, R39W.

1845 Austin Burt intersected the left bank of the Ontonagon River 15.50 Chains (1023.0') North of the Section Corner and set a post with ties:
20' Cedar S 72°W 20 links

No Record of Susequent Restoration.

B. Description of corner evidence found and/or method applied in restoring or reestablishing corner:

I found no remains of the original corner or accessories. Corner has been washed out by bank erosion of the Ontonagon River. I re-established a position for the Meander Corner by single proportionate Measurement but was unable to monument it as it fell in the river. I therefore set a Witness Corner to the Meander Corner, on line between the Meander Corner position and the Section Corner to the south and 87.58' distant from the Meander Corner.

Research on file with County Remonumentation Representative.



C. Description of monument for corner and accessories established to perpetuate locating the position of the corner:

Witness Corner to the Meander corner is a 2 1/2" x 30" aluminum pipe with a 3" diameter aluminum cap stamped to read: County Remonumentation; T51N, R40W, R39W; W.C.M.C.; S. 13, S. 18; 1999; P.S. 37273. Corner falls 60' south of the present left bank of the Ontonagon River. Ties:

3" Hard Maple	N 26°E	8.05'
12" Hard Maple	S 24°E	24.47'
Steel Sign Rail	South	1.09' (to face)
10" Basswood	S 33°W	50.88'
12" Box Elder	N 52°W	14.38'
SW Corner Section 18	S 00°33'27"W	943.62'
W 1/4 Corner Section 18	N 00°33'27"W	1717.55'
M.C. on Right Bank	N 00°33'27"W	426.88'

NOTE: Bearings to witness objects are magnetic. Distances are to a nail in side of the witness object unless noted.

DEER GROUP APPROVED
Lad W Applkamp
COUNTY REMONUMENTATION
11-09-99

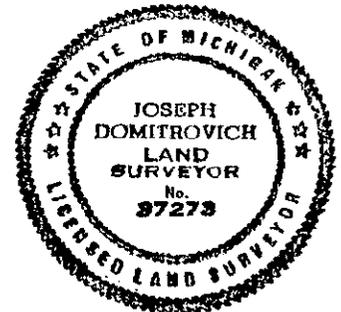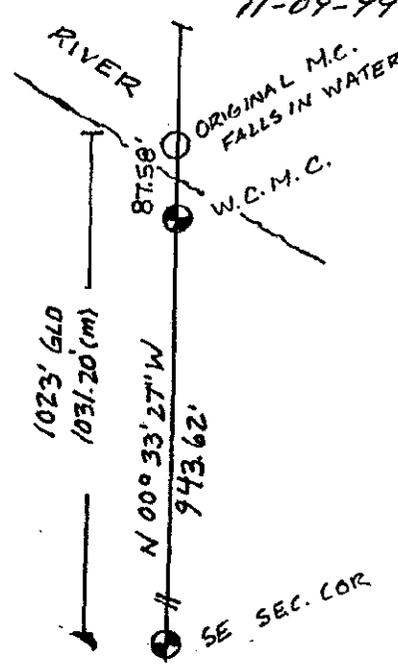

Signed by *J. C. Domitrovich*

Date 11/09/99

Surveyor's Michigan License No. 37273