

LAND CORNER RECORDATION CERTIFICATE
Filing Requirement of Act 74, Mich. P.A. 1970

For corners in
Ontonagon
(County)

Located In:

Corner Code #

1. Public Land Survey

T 51N R 40W

A-2/3 #1

T 51N R 41W

M-2/3 #1

T R

T R

2. Property Controlling
in Section

S T R

S T R

3. Miscellaneous
Property in Section

S T R

S T R

4. Lot No. , Recorded Plat

5. Private Claims

SURVEY &
REMONUMENTATION

MAY 22 1997

COMMISSION

Register of Deeds Stamp & File Number

I, Joseph C. Domitrovich, in a field survey on October 1, 1996, do hereby certify that under requirements of P.A. 74, Michigan P.A. of 1970, the corner points mentioned in lines 1 and 2 above were in conformance with regulations and rules therefore as required in the current manual of survey instructions of the United States Department of the Interior, Bureau of Land Management or by a decree of a Court of Law and/or that the corner points mentioned in lines 3, 4 and 5 above were in conformance with the rules of the Michigan Board of Professional Surveyors or by a Decree of a Court of Law; established, re-established, monumented, re-monumented, recovered, found as expressed below:

NOTE: Not more than 4 corners, all in the same town and range, may be recorded on this certificate.

A. Description of original monument and accessories and/or subsequent restoration:

(A-2/3) Meander Corner to Section 6, T51N, R40W, and Section 1, T51N, R41W

1845 - William A. Burt set post

10" Cedar S 43° W 26 links

14" Birch S 47° E 8 links

1940 - T.H. Wilcox, P.E., in Supervisor's Plat of Government Lots 3 & 4, Section 6, T51N, R40W, shows the section line intersecting Lake Superior but does not show that he monumented it.

1969 - M.S.H.D. in M-64 Highway Plans, shows that the Meander Corner is a 1 1/2" iron pipe. They give three witnesses and an angle and distance to it off centerline.

B. Description of corner evidence found and/or method applied in restoring or reestablishing corner:

Original corner and accessories have been washed out by shoreline erosion. I found a 1 1/2" pipe which worked well with highway angles and distances off centerline and with two remaining witnesses.

I accepted the pipe as the Meander Corner. The pipe will be completely washed out in a few years, so I established a witness corner to the Meander Corner 30.00' to the South and on the section line. I established new bearing trees and bearing objects to this witness corner since it will be in existence longer.

Research on file with County Remonumentation Representative.

C. Description of monument for corner and accessories established to perpetuate locating the position of the corner:

Corner is a 2" x 30" aluminum pipe with a 3" diameter aluminum cap stamped to read: W.C.M.C.; S. 1, S. 6; T.51N, R. 41W, R40W; 1996; P.S. 37273; COUNTY REMONUMENTATION. Corner falls 72' South of shore of Lake Superior.


Witnesses:

1 1/2" Iron Pipe	North	30.00'	(M.S.H.D. Meander Corner)
Steel Sign Post	North	22.86'	
Anchor Pole	S 48° E	23.15'	
SW Cor Garage Fdn	S 21° E	58.55'	
10" Maple in Clump	S 58° W	72.46'	
12" Maple	N 67° W	38.08'	

PEER GROUP APPROVED

Earl W. Applekamp
COUNTY REPRESENTATIVE

10-16-96

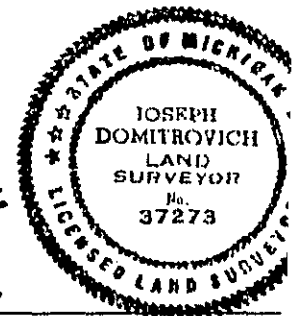

NOTE: Bearings are magnetic. Distances are to nail in side of witness objects unless noted.

Signed by Joseph C. Domitrovich

Date 10/15/96

Surveyor's Michigan License No. 37273

FORM APPROVED BY MICHIGAN STATE BOARD OF PROFESSIONAL SURVEYORS, JAN. 28, 1995
REVISED MAY 14, 1995
REVISED JAN., 1996

- SKETCH ON BACK -
219

