

SURVEY & REMONUMENTATION

APR 29 1996

COMMISSION

LAND CORNER RECORDATION CERTIFICATE

Filing Requirement of Act 74, Mich. P.A. 1970

JUDITH D. ROEHM
Ontonagon County
LC 3/ 353 JEM Fee: 9.00
Page 1 of 1

For corners in
Ontonagon
(County) Located In: Corner Code #

- | | | |
|--------------------------------------|---------------------------|------------|
| 1. Public Land Survey | T <u>52N</u> R <u>39W</u> | <u>003</u> |
| | T <u>52N</u> R <u>39W</u> | <u>003</u> |
| 2. Property Controlling in Section | S <u>52N</u> T <u>39W</u> | |
| 3. Miscellaneous Property in Section | S <u>52N</u> T <u>39W</u> | |

Register of Deeds Stamp & File Number

4. Lot No. _____, Recorded Plat _____
5. Private Claims _____

I, Joseph C. Domitrovich, in a field survey on October 2, 19 95, do hereby certify that under requirements of P.A. 74, Michigan P.A. of 1970, the corner points mentioned in lines 1 and 2 above were in conformance with regulations and rules therefore as required in the current manual of survey instructions of the United States Department of the Interior, Bureau of Land Management or by a decree of a Court of Law and/or that the corner points mentioned in lines 3, 4 and 5 above were in conformance with the rules of the Michigan Board of Professional Surveyors or by a Decree of a Court of Law; established, re-established, monumented, re-monumented, recovered, found as expressed below:

NOTE: Not more than 4 corners, all in the same town and range, may be recorded on this certificate.

A. Description of original monument and accessories and/or subsequent restoration:

Meander Corner, Sections 17 and 20, T52N R39W

1845-William A. Burt intersected the shore of Lake Superior 5.98 links (394.7') west of the corner of Sections 16, 17, 20 and 21 and set meander corner.

14" White Pine N 74° E 86 links

1971-Robert Mick, P.S. 16936, for Turner's Lakeview Plat No. 2, shows the section line intersecting Lake Superior but does not show a meander corner set.

B. Description of corner evidence found and/or method applied in restoring or reestablishing corner:

The shoreline of Lake Superior has eroded considerably since the original corner was established, and no evidence of it remains.

Could find no evidence of a meander corner set by Mick.

Re-established the Section line west of the corner of Sections 16, 17, 20 and 21 using existing monuments from the above mentioned Plat.

Established a witness corner to the meander corner on the re-established section line, at a distance of 156' west of the section corner.

(Research on file with County Remonumentation Representative.)

C. Description of monument for corner and accessories established to perpetuate locating the position of the corner:

Corner is a 3/4" x 36" aluminum rod with a 3" diameter stamped aluminum cap, driven into clay under beach sand. Corner falls 83' east of the shore of Lake Superior.

Witnesses:

12" White Birch East 63.63'

6" White Birch S 31° E 30.32'


Corner of Sections 16, 17, 20 and 21 (Stamped monument) S 88° E 156.00'

Witness corner to the meander corner Sections 16 and 17 (Stamped Monument) N 52° E 196.15'

Metal Sign Post West 0.65'

PEER GROUP APPROVED

Paul W. Applekamp
COUNTY REPRESENTATIVE
10-18-95

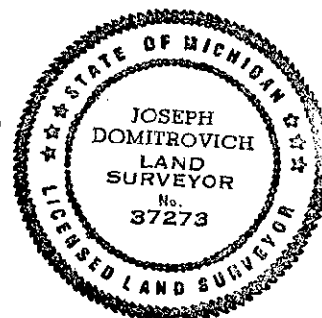

NOTE: Bearings are magnetic. Distances are to nail in side of witness objects unless noted.

Signed by J. C. Domitrovich

Date 10/18/95

Surveyor's Michigan License No. 37273

FORM APPROVED BY MICHIGAN STATE BOARD OF PROFESSIONAL SURVEYORS, JAN. 28, 1971
REVISED MAY 14, 1975
REVISED JAN., 1983