

MICHIGAN
DEPARTMENT OF CONSERVATION
FORESTRY DIVISION

LAND CORNER RECORD

T. 53 N.R. 38 W


Ontonagon COUNTY

DESCRIPTION OF CORNER Section Corner common to Secs. * 14-15-22-23

CORNER MONUMENT 1" Pipe with 4" Aluminum Cap

DATE MONUMENT PLACED AND WITNESSED 2/16/1965

WITNESSES TO CORNER..... Corner lies in Tag Alder River bottom. No trees available

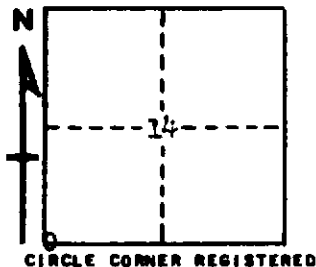

AND

DESCRIPTION IN DETAIL AS TO HOW CORNER WAS LOCATED AND IDENTIFIED OR RESTORED.

This Corner was re-established on an old ~~E-W~~ blazed line, which agrees with position of stream to North and Line Tree to South.

SURVEYOR'S SEAL

SIGNED Billy D. Buckler DATE April 7, 1965
REGISTERED LAND SURVEYOR