

LAND CORNER RECORDATION CERTIFICATE
Filing Requirement of Act 74, Mich. P.A. 1970

For corners in
PRESQUE ISLE
(County)

Located In:

Corner Code ##

1. Public Land Survey

T 33N R 2E
T R
T R
T R

A-9, A-10,
B-9

2. Property Controlling
in Section

S 30 T R
S T R

3

3. Miscellaneous
Property in Sec.

S T R
S T R

Register of Deeds Stamp & File Number

4. Lot No. , Recorded Plat

5. Private Claims

I, CARL T. KIICKILA, in a field survey on NOVEMBER 14, 19 95,
do hereby certify that under requirements of P.A. 74, Michigan P.A. of 1970, the corner points mentioned
in lines 1 and 2 above were in conformance with regulations and rules therefore as required in the
current manual of survey instructions of the United States Department of the Interior, Bureau of Land
Management or by a decree of a Court of Law and/or that the corner points mentioned in lines 3, 4 and 5
above were in conformance with the rules of the Michigan Board of Land Surveyors or by a Decree of a
Court of Law; established, re-established, monumented, re-monumented, recovered, found as
expressed below:

NOTE: Not more than 4 corners, all in the same town and range, may be recorded
on this certificate.

A. Description of original monument and accessories and/or subsequent restoration:

A-9


A-10

B-9

(NO EVIDENCE OF G.L.D. CORNER, B.T.'S, LINE TREES & TOPOGRAPHY,
AS CALLED OUT IN THE G.L.D. LINE NOTES; UNLESS NOTED IN ITEM "B"
BELOW.)

	A	B	C	D	E	F	G	H	I	J	K	L	M
2	6	5	4	3	2	1							
3													
4	7	8	9	10	11	12							
5													
6	18	17	16	15	14	13							
7													
8	19	20	21	22	23	24							
9													
10	30	29	28	27	26	25							
11													
12	31	32	33	34	35	36							
13													

3

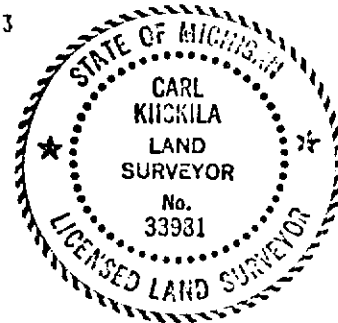

B. Description of corner evidence found and/or method applied in restoring or reestablishing corner:

A-9

A-10

B-9

3

FD & ACCEPTED A 1 1/2" PIPE
W/CONC AS SET BY MICH DEPT OF
CONSERVATION SURVEYOR MARCUS
SCHAAF FOR THE NW CORNER OF
SEC 30. THIS CORNER WAS ALSO
ACCEPTED BY RLS DELMER PORTER
AND SHELL OIL CO. DURING
SUBSEQUENT SURVEYS. SE COR OF
CLEARCUT IS 5' EAST. N-S
TRAIL RD IS 25' EAST. CORNER
IS IN LINE W/FIRELANE-TRAIL
ROAD TO EAST.

FOUND OLD BROKEN PRESQUE ISLE
CO MONUMENT LAYING ON A 30"
PINE STUMP THOUGHT TO BE THE
STUMP OF THE ORIGINAL CORNER
AS CALLED FOR IN THE ORIG
SURVEY. SET STANDARD DNR MON
FROM RLS RONALD BISCHER
WITNESS TAGS & NAILS. SEE
PRESQUE ISLE CO. LAND CORNER
RECORDS CERT, PAGE 566 FOR
MORE INFORMATION.

FD & ACCEPTED A PRESQUE ISLE
CO CONC MON WITH BRASS CAP AS
SET BY LS DELMER PORTER FROM
FD ORIGINAL B.T. STUMPS. SEE
LIBER 1, PAGES 36 & 372 OF THE
CORNER RECORDS FOR MORE
INFORMATION.

ESTABLISHED THE NW CORNER OF
THE FRACTIONAL SW 1/4 OF THE
FRACTIONAL NW 1/4 SEC 30 BY
STANDARD BLM PROCEDURE FOR
SUBDIVISION OF A SECTION. N-S
BRUSHED LINE IS 13' EAST.

C. Description of monument for corner and accessories established to perpetuate locating the position of the corner:

A-9

A-10

B-9

3

FD 1 1/2" IR PIPE, SET 5/8" x
32" REBOD W/CAP(INSIDE). SET
CARSONITE POST 1' NORTH.
6" MAPLE S88°W 10.07'
5" OAK N08°W 45.44'
6" OAK N51°E 14.66'
7" R PINE S11°W 45.18'
#6" J PINE S16°E 20.11'

STD DNR MON W/CARSONITE POST.
#36" DEAD W PINE S44°W 44.44'
#14" TAMARACK S76°E 27.27'
6" MAPLE N89°W 3.09'
8" TAMARACK N16°E 34.34'
5" TAMARACK N10°W 47.12'
#WIT BY R. BISCHER 1981.

FD PRESQUE ISLE CO MON IN E-W
FIRELANE.
5" MAPLE N53°W 19.09'
#10" J PINE N73°E 36.31'
#12" J PINE S59°E 50.11'
J PINE S52°W 35.42'
4" IR PIPE
FENCE COR N79°W 51.1'

SET 1" x 66" IR PIPE W/CAP &
CARSONITE POST 1' NORTH.
14" CEDAR S38°W 14.28'
14" CEDAR N32°W 9.21'
4" & 8" TW CEDAR S57°E 8.37'
7" BALSAM N23°E 28.28'

*OLD WIT BY PORTER SURVEYS.

*OLD WITS BY OTHERS.

Signed by

Carl T. Kiickila

Date

4-3-96

Surveyor's Michigan License No.

33981