

LAND CORNER RECORDATION CERTIFICATE
Filing Requirement of Act 74, Mich. P.A. 1970

For corners in

Presque Isle
(County)

Located In:

Corner Code ##

- | | | |
|------------------------------------|---|-------------|
| 1. Public Land Survey | T <u>33N</u> R <u>4E</u> | <u>I-10</u> |
| | T <u>33N</u> R <u>4E</u> | <u>H-10</u> |
| | T <u> </u> R <u> </u> | <u> </u> |
| | T <u> </u> R <u> </u> | <u> </u> |
| 2. Property Controlling in Section | S <u>35</u> T <u>33N</u> R <u>4E</u> | <u>12</u> |
| | S <u>27</u> T <u>33N</u> R <u>4E</u> | <u>5</u> |
| 3. Miscellaneous | S <u> </u> T <u> </u> R <u> </u> | <u> </u> |
| Property in Sec. | S <u> </u> T <u> </u> R <u> </u> | <u> </u> |

Register of Deeds Stamp & File Number

4. Lot No. , Recorded Plat
5. Private Claims

I, Carl R. Johnson, in a field survey on May 23, & May 24, 19 88, do hereby certify that under requirements of P.A. 74, Michigan P.A. of 1970, the corner points mentioned in lines 1 and 2 above were in conformance with regulations and rules therefore as required in the current manual of survey instructions of the United States Department of the Interior, Bureau of Land Management or by a decree of a Court of Law and/or that the corner points mentioned in lines 3, 4 and 5 above were in conformance with the rules of the Michigan Board of Land Surveyors or by a Decree of a Court of Law; established, re-established, monumented, re-monumented, recovered, found as expressed below:

NOTE: Not more than 4 corners, all in the same town and range, may be recorded on this certificate.

A. Description of original monument and accessories and/or subsequent restoration:

	A	B	C	D	E	F	G	H	I	J	K	L	M
2	6		5		4		3		2		1		
3													
4	7		8		9		10		11		12		
5													
6	18		17		16		15		14		13		
7													
8	19		20		21		22		23		24		
9													
10	30		29		28		27		26		25		
11													
12	31		32		33		34		35		36		
13													

B. Description of corner evidence found and/or method applied in restoring or reestablishing corner:

I-10 - Set at found post point with witnesses (NBT) from Scott Engineering Survey approximately 30 years ago.

H-10 - Set at computed intersection of 1/4 lines.

12 - Set by standard survey procedure for subdivision of a section.

5 - Set by standard survey procedure for subdivision of a section.

C. Description of monument for corner and accessories established to perpetuate locating the position of the corner:

I-10 - E 1/4 Corner

DNR Mon. Cedar Post
 Red Pine 22" N23°W 23.0'
 White Pine 24" N45°E 51.4'
 Spruce 6" S32°W 17.0'

12 - S1/8 Cor. on the N-S 1/4 line

5/8" bar w/cap, Cedar Post
 White Birch 8" N 7°W 23.5'
 Cedar 12" S64°E 37.9'

H-10 -Center of Section 27


DNR Mon. Cedar Post
 Jack Pine 14" S30°E 22.50'
 Jack Pine 8" N42°W 18.28'
 Jack Pine 10" N53°E 23.90'

Using Scott Engr. Witnesses

5 - N 1/8, on the N-S 1/4 Line

5/8" bar w/cap, Cedar Post
 Maple 8" S42°W 12.7'
 White Pine 6" N 3°E 34.9'

Signed by Carl R. Johnson
 Surveyor's Michigan License No. 30083

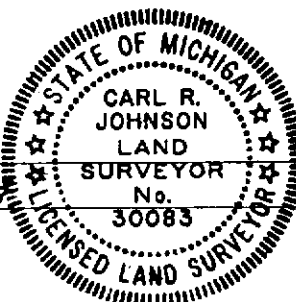

Date 6/22/88