

1999 DEC -2 PM 2:12

LAND CORNER RECORDATION CERTIFICATE  
Filing Requirement of Act 74, Mich. P.A. 1970

For corners in

Presque Isle  
(County)

Located In:

Corner Code #

## 1. Public Land Survey

T 34 R 4E

A-8

2. Property Controlling  
in Section

S

T R

3. Miscellaneous  
Property in Sec.

S

T R

S

T R

4. Lot No. \_\_\_\_\_, Recorded Plat \_\_\_\_\_  
5. Private Claims \_\_\_\_\_

I, Delmer E. Porter, in a field survey on Nov. 10, 1999 do hereby state that under requirements of P.A. 74, Michigan P.A. of 1970, the corner points mentioned in lines 1 and 2 above were in conformance with regulations and rules therefore as required in the current manual of survey instructions of the United States Department of the Interior, Bureau of Land Management or by a decree of a Court of Law and/or that the corner points mentioned in lines 3, 4 and 5 above were in conformance with the rules of the Michigan Board of Land Surveyors or by a Decree of a Court of Law; established, re-established, monumented, recovered, found as expressed below:

NOTE: Not more than 2 corners, all in the same town and range, may be recorded on this certificate.


## A. Description of original monument and accessories and/or subsequent restoration:

A-8 GLO Notes - 1855  
Set 1/4 Section Post  
Sugar 28" West 10 Lks  
Aspen 11" S30°W 44 Lks

R. Bischer #22428, L 1, Pg 576  
1/2" Rod & Cap/Set by S.P.  
S74°E 24.04' 8" W. Ash  
S51°W 7.33' 6" W. Ash  
N22°W 2.44' 5" W. Birch

## B. Description of corner evidence found and/or method applied in restoring or reestablishing corner:

A-8 Found 1/2" Rod & Cap in Place  
And 3 of Bischer's witnesses with tag & nail  
This is 109.72' North and one line from the  
1/2" Rod used by Scott in dividing Sec 24,  
T34N, R3E (Recorded Lib 1, Page 160)

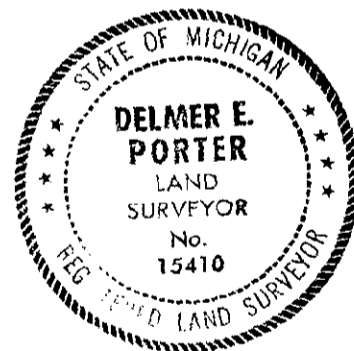

## C. Description of monument for corner and accessories established to perpetuate locating the position of the corner:

A-8 1/2" Rod & Cap  
S05°W 16.44' 7" W. Ash  
S54°W 7.31' 8" W. Ash  
N17°W 2.41' 8" W. Birch  
S78°E 23.99' 11" W. Ash  
South 109.72' 1/2" Rod

\*Witness tags &amp; nails used.

Ratified by Peer Group  
in accordance with P.A. 345  
Chairman Norman J. O'Brien  
Date 11/30/99

Signed by

Delmer E. Porter

Date

11-15-99Surveyor's Michigan License No. #15410