

8799

1999 PRESQUE ISLE COUNTY, STATE OF MICHIGAN,
LAND CORNER REMONUMENTATION

DEC 29 1999

LIBER 335 PAGE 216

SECTION

LAND CORNER RECORDATION CERTIFICATE
Filing Requirement of Act 74, Mich. P.A. 1970

For corners in
PRESQUE ISLE

(County)

Located in:

Corner Code #

BISMARCK TWP.

C-7 ✓

1. Public Land Survey

T 34N R 4E

T R

T R

T R

2. Property Controlling
in Section

S T R

S T R

3. Miscellaneous
Property in Sec.

S T R

S T R

Recorded

Dec 20, 1999

At 10:30 o'clock A M

Janet M. Lamb
Reg. of Deeds, Presque Isle Co. MI

Register of Deeds Stamp & File Number

4. Lot No. _____ Recorded Plat _____
5. Private Claims _____

	A	B	C	D	E	F	G	H	I	J	K	L	M
1													
2	6		5		4		3		2		1		
3													
4	7		8		9		10		11		12		
5													
6	18		17		16		15		14		13		
7													
8	19		20		21		22		23		24		
9													
10	30		29		28		27		26		25		
11													
12	31		32		33		34		35		36		
13													

I, James A. Beck, in a field survey on Dec 8, 1999 do hereby state that under requirements of P.A. 74, Michigan P.A. of 1970, the corner points mentioned in lines 1 and 2 above were in conformance with regulations and rules therefore as required in the current manual of survey instructions of the United States Department of the Interior, Bureau of Land Management or by a decree of a Court of Law and for that the corner points mentioned in lines 3, 4 and 5 above were in conformance with the rules of the Michigan Board of Land Surveyors or by a Decree of a Court of Law; established, re-established, monumented, recovered, found as expressed below:

NOTE: Not more than 2 corners, all in the same town and range, may be recorded on this certificate.

A. Description of original monument and accessories and/or subsequent restoration:

C-7 1856 G.L.O. by Alfred Millerd
"Set post cor. of Secs. 17, 18, 19 & 20"
Cedar 12 N27W 29; Cedar 12 S 21E 14

Dec. 15, 1980; P.A. 74 Certificate by Delmer Porter RLS 15410
"fd. 4"x 4" Cedar stake & stake point @
fe. corner, could not find OBT"
"Set 1/2" rod and cap"; N37°E 23.93' 5" Cedar
S63°E 32.75' 5" Cedar; N60°W 44.84' 7" Cedar


B. Description of corner evidence found and/or method applied in restoring or reestablishing corner:

C-7 December 8, 1999 Remonumentation by James A. Beck P.S. 21559
found 1/2" inch rod partially pulled from position and broken 15410 cap, and found old
stake point driven alongside of iron
N37°E 23.93' 7" Cedar, 15410 tag
S63°E 32.75' 8" Cedar stump
N60°W 44.84' 9" Cedar

in accordance with P.A. 345
Chairman Norman J. Pucci
Date 12/14/99

C. Description of monument for corner and accessories established to perpetuate locating the position of the corner:

C-7 December 8, 1999 Remonumentation by James A. Beck P.S. 21559
1/2" inch rod and P.S. 21559 cap
N37°E 23.93' 7" Cedar, 15410 tag; S63°E 32.75' 8" Cedar stump
N60°W 44.84' 9" Cedar; set 2 additional witnesses:
S61°E 24.4', P.S. 21559 tag in 7" Cedar; S17°W 19.75', P.S. 21559 tag in 9" Maple
Corner falls in edge of Cedar swamp Easterly of stream in marsh near tree hunting blind.

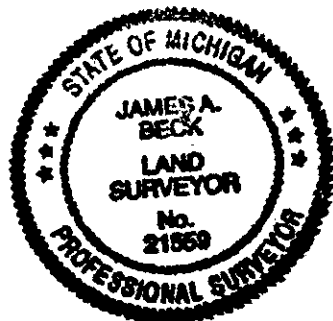

Signed by

Surveyor's Michigan License No. 21559

Date

12-18-1999