

1999 PRESQUE ISLE COUNTY, STATE OF MICHIGAN,
LAND CORNER REMONUMENTATION

LIBER 335 PAGE 226

DEC 28 1999

SECTION

LAND CORNER RECORDATION CERTIFICATE
Filing Requirement of Act 74, Mich. P.A. 1970

For corners in
PRESQUE ISLE

(County)

Located in:

BISMARCK TWP.

Corner Code #

D-9 ✓

1. Public Land Survey

T 34N R 4E

T R

T R

T R

T R

2. Property Controlling
in Section

S T R

S T R

3. Miscellaneous
Property in Sec.

S T R

S T R

Recorded Dec 20, 1999
At 10:30 o'clock A. M
Janet M. Lamb
Reg. of Deeds, Presque Isle Co. MI

Register of Deeds Stamp & File Number

4. Lot No. _____, Recorded Plat _____

5. Private Claims _____

I, James A. Beck, in a field survey on Dec 7, 1999, do hereby state that under requirements of P.A. 74, Michigan P.A. of 1970, the corner points mentioned in lines 1 and 2 above were in conformance with regulations and rules therefore as required in the current manual of survey instructions of the United States Department of the Interior, Bureau of Land Management or by a decree of a Court of Law and/or that the corner points mentioned in lines 3, 4 and 5 above were in conformance with the rules of the Michigan Board of Land Surveyors or by a Decree of a Court of Law; established, re-established, monumented, recovered, found as expressed below.

NOTE: Not more than 2 corners, all in the same town and range, may be recorded on this certificate.

	A	B	C	D	E	F	G	H	I	J	K	L	M
1													
2	6		5		4		3		2		1		
3													
4	7		8		9		10		11		12		
5													
6	18		17		16		15		14		13		
7													
8	19		20		21		22		23		24		
9													
10	30		29		28		27		26		25		
11													
12	31		32		33		34		35		36		
13													

A. Description of original monument and accessories and/or subsequent restoration:

D-9 1856 G.L.O. by Alfred Millerd "Set qr. Sec post"
Y. Pine 16 N70°E 6; Y. Pine 16 S70W 32

Chairman _____
Date _____


B. Description of corner evidence found and/or method applied in restoring or reestablishing corner:

D-9 December 7, 1999 Remonumentation by James A. Beck P.S. 21559
found no evidence of original corner; Set 1/2" iron and P.S. 21559 cap
by single proportionate method using Section Corners immediately East and West

County Post Group
in accordance with P.A. 345
Chairman James A. Beck
Date 12/14/99

C. Description of monument for corner and accessories established to perpetuate locating the position of the corner:

D-9 December 7, 1999 Remonumentation by James A. Beck P.S. 21559
1/2" iron and P.S. 21559 cap
S40°W 22.52' P.S. 21559 tag in 12" Oak
S25°E 31.39' " " " in 4" W. Pine
S80°E 31.64' " " " in 6" Oak
N10°W 79.40' " " " in 16" Oak; West 42' +/- to single wire N-S fence

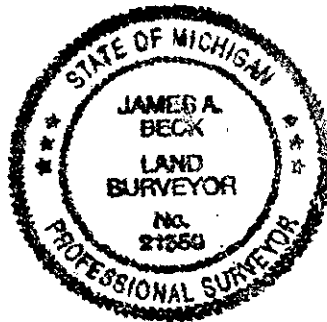

Signed by James A. Beck
Surveyor's Michigan License No. 21559

Date 12-18-1999