

DEC 29 1999

LAND CORNER RECORDATION CERTIFICATE  
Filing Requirement of Act 74, Mich. P.A. 1970

SECTION

For corners in

Presque Isle  
(County)

Located In:

Corner Code #

1. Public Land Survey

T 34N R 4E E-2 ✓

2. Property Controlling  
in Section

S T R

3. Miscellaneous  
Property in Sec.

S T R

Recorded Dec. 16, 1999  
At 11:30 clock A. M.  
Janet M. Lamb  
Reg. of Deeds, Presque Isle Co. MI

Register of Deeds Stamp & File Number

4. Lot No. \_\_\_\_\_, Recorded Plat \_\_\_\_\_  
5. Private Claims \_\_\_\_\_

I, Ronald Bischer, in a field survey on Aug. 18, 1999 do hereby state that under requirements of P.A. 74, Michigan P.A. of 1970, the corner points mentioned in lines 1 and 2 above were in conformance with regulations and rules therefore as required in the current manual of survey instructions of the United States Department of the Interior, Bureau of Land Management or by a decree of a Court of Law and/or that the corner points mentioned in lines 3, 4 and 5 above were in conformance with the rules of the Michigan Board of Land Surveyors or by a Decree of a Court of Law; established, re-established, monumented, recovered, found as expressed below:

NOTE: Not more than 2 corners, all in the same town and range, may be recorded on this certificate.

	A	B	C	D	E	F	G	H	I	J	K	L	M
1													
2	6			5	•	4		3		2		1	
3													
4	7			8		9		10		11		12	
5													
6	18			17		16		15		14		13	
7													
8	19			20		21		22		23		24	
9													
10	30			29		28		27		26		25	
11													
12	31			32		33		34		35		36	
13													

A. Description of original monument and accessories and/or subsequent restoration:

E-2  
1856 GLO Notes  
Wood Post  
S62°E 37 lks 10" Spruce pine  
N72°W 42 lks 10" Yellow pine

March 10, 1992  
Norman Quaine #33984  
½" rod and cap #15410  
S28°W 23.36' 14" Oak  
N13°W 51.21' 14" J. Pine  
N19°E 28.53' 12" J. Pine  
N53°E 38.26' 14" J. Pine

B. Description of corner evidence found and/or method applied in restoring or reestablishing corner:


E-2  
Aug. 18, 1999  
Presque Isle County Remonumentation  
Ronald Bischer #22428

found ½" rod and cap #15410  
one old witness

C. Description of monument for corner and accessories established to perpetuate locating the position of the corner:

E-2  
½" rod and cap #15410  
S26°W 23.36' 14" Oak  
S60°E 34.21' 5" Aspen  
N72°E 21.47' 6" Birch  
N48°W 40.50' 5" Maple

Ratified by Peer Group  
in accordance with P.A. 345  
Chairman Norman Quaine  
Date 11/30/99

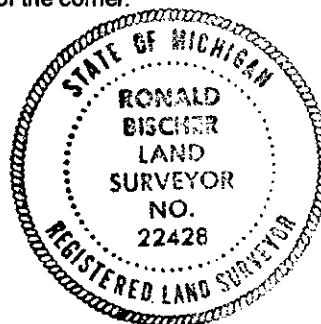

Signed by Ronald R. Bischer  
Surveyor's Michigan License No. 22428

Date 12-13-99