

DEC 29 1999

1999 PRESQUE ISLE COUNTY REMONUMENTATION

LAND CORNER RECORDATION CERTIFICATE
Filing Requirement of Act 74, Mich. P.A. 1970

SECTION

For corners in

Presque Isle
(County)

Located In:

Corner Code #

1. Public Land Survey

B4N R4E

F-5

2. Property Controlling
in SectionS
ST R
T R3. Miscellaneous
Property in Sec.S
ST R
T R4. Lot No. _____, Recorded Plat _____
5. Private Claims _____

I, Ronald Bischer, in a field survey on Aug. 29, 99 do hereby state that under requirements of P.A. 74, Michigan P.A. of 1970, the corner points mentioned in lines 1 and 2 above were in conformance with regulations and rules therefore as required in the current manual of survey instructions of the United States Department of the Interior, Bureau of Land Management or by a decree of a Court of Law and/or that the corner points mentioned in lines 3, 4 and 5 above were in conformance with the rules of the Michigan Board of Land Surveyors or by a Decree of a Court of Law; established, re-established, monumented, recovered, found as expressed below:

NOTE: Not more than 2 corners, all in the same town and range, may be recorded on this certificate.

Recorded

At 11:30 o'clock A M
Janet M. Lamb
Reg. of Deeds, Presque Isle Co. MI

Register of Deeds Stamp & File Number

	A	B	C	D	E	F	G	H	I	J	K	L	M
1													
2	6			5		4		3		2		1	
3													
4	7			8		9		10		11		12	
5													
6	18			17		16		15		14		13	
7													
8	19			20		21		22		23		24	
9													
10	30			29		28		27		26		25	
11													
12	31			32		33		34		35		36	
13													

A. Description of original monument and accessories and/or subsequent restoration:

F-5

1856 GLO Notes

S18°E 16 lks 8" Spruce

N25°W 7 lks 5" Spruce

Oct. 6, 1987 Delmer Porter #15410

set 1/2" rod and cap by SP

N78°W 20.57' 13" Balsam

S42°W 27.26' 4" Balsam

S11°W 34.15' 5" Cedar

Aug. 24, 1994 Norman Quaine #33984
No witnesses

B. Description of corner evidence found and/or method applied in restoring or reestablishing corner:

F-5

Aug. 20, 1999 Presque Isle County Remonumentation

Ronald Bischer #22428

found 1/2" rod and cap and 3 witnesses

C. Description of monument for corner and accessories established to perpetuate locating the position of the corner:

F-5

1/2" rod and cap #15410

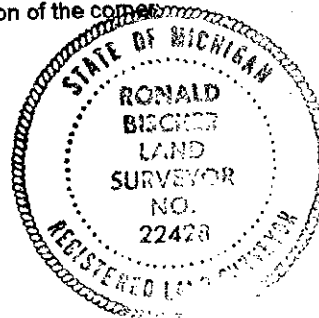
N78°W 20.57' 9" Balsam

S42°W 27.26' 9" Balsam

S11°W 34.15' 8" Cedar

N45°E 5.78' 7" Birch

Qualified by Peer Group
in accordance with P.A. 345

Chairman Norman QuaineDate 11/30/99

Signed by

Ronald E. Bischer

Date

12-13-99

Surveyor's Michigan License No.

22428