

2507

LAND CORNER RECORDATION CERTIFICATE
Filing Requirement of Act 74, Mich. P.A. 1970

For corners in

Presque Isle
(County)

Located in:

Corner Code #

- | | | |
|------------------------------------|----------|-----|
| 1. Public Land Survey | T34NR 4E | G-3 |
| | T R | |
| | T R | |
| | T R | |
| 2. Property Controlling in Section | S T R | |
| | S T R | |
| 3. Miscellaneous Property in Sec. | S T R | |
| | S T R | |

PRESQUE ISLE COUNTY
RECORDED

98 DEC 17 PM 4:25


Janet M. Lamb
REGISTER OF DEEDS

Register of Deeds Stamp & File Number

4. Lot No. _____, Recorded Plat _____
5. Private Claims _____

I, Delmer E. Porter in a field survey on July 2, 1998 do hereby state that under requirements of P.A. 74, Michigan P.A. of 1970, the corner points mentioned in lines 1 and 2 above were in conformance with regulations and rules therefore as required in the current manual of survey instructions of the United States Department of the Interior, Bureau of Land Management or by a decree of a Court of Law and/or that the corner points mentioned in lines 3, 4 and 5 above were in conformance with the rules of the Michigan Board of Land Surveyors or by a Decree of a Court of Law, established, re-established, monumented, recovered, found as expressed below:

NOTE: Not more than 2 corners, all in the same town and range, may be recorded on this certificate.

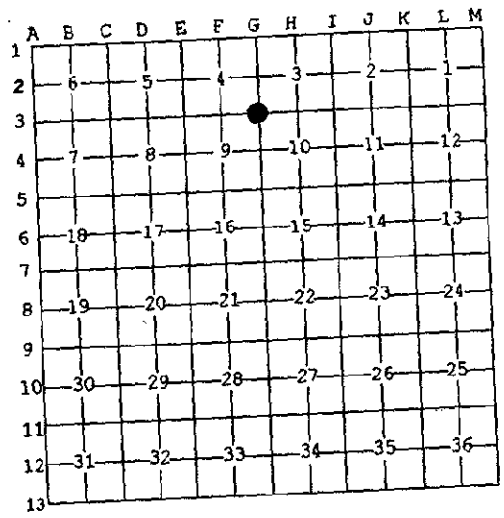

A. Description of original monument and accessories and/or subsequent restoration:

G-3 GLO NOTES
June 26, 1856
Set Post Cor of Sec 3, 4, 9 & 10
W Birch 12 N70E 28 Links
W Birch 8 S30W 12 Links

GLO NOTES
June 26, 1856
Old corner of Sections 3 & 4
Birch 12 N40W 26
Hemi 10 S71E 24

SURVEY &
REMONUMENTATION

JAN 14 1999

B. Description of corner evidence found and/or method applied in restoring or reestablishing corner:

G-3 Set 1/2" Rod & Cap #15410
At Fence Intersection
N02°W 10.08' 4" Maple
S76°E 24.06' 5" Maple


SECTION

Ratified by Peer Group
in accordance with P.A. 345

Chairman *Norman J. Quisner*
Date 12/17/98

C. Description of monument for corner and accessories established to perpetuate locating the position of the corner:

G-2 1/2" Rod & Cap #15410
3 N02°W 10.08' 4" Maple (Broke 3' High)
S76°E 24.06' 5" Maple
N38°W 15.56' 4" Maple
S45°E 10.00' 3" Maple
S10°W 7.56' 3" Scotch Pine

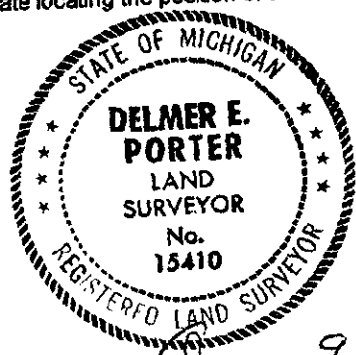

Signed by *Delmer E. Porter*
Surveyor's Michigan License No. #15410

Date Dec 9, 1998