

2519

1998 PRESQUE ISLE COUNTY, STATE OF MICHIGAN REMONUMENTATION

LAND CORNER RECORDATION CERTIFICATE
Filing Requirement of Act 74, Mich. P.A. 1970

For corners in

<u>Presque Isle</u> (County)	Located In:	Corner Code #
1. Public Land Survey	T <u>34</u> R <u>4E</u>	<u>H-3</u>
	T <u> </u> R <u> </u>	<u> </u>
	T <u> </u> R <u> </u>	<u> </u>
	T <u> </u> R <u> </u>	<u> </u>
2. Property Controlling in Section	S <u> </u> T <u> </u> R <u> </u>	<u> </u>
	S <u> </u> T <u> </u> R <u> </u>	<u> </u>
3. Miscellaneous Property in Sec.	S <u> </u> T <u> </u> R <u> </u>	<u> </u>
	S <u> </u> T <u> </u> R <u> </u>	<u> </u>

PRESQUE ISLE COUNTY
RECORDED

98 DEC 17 PM 4: 27

Janet M. Lamb
REGISTER OF DEEDS

Register of Deeds Stamp & File Number

4. Lot No. , Recorded Plat
5. Private Claims

I, Delmer E. Porter in a field survey on July 2, 1998 do hereby state that under requirements of P.A. 74, Michigan P.A. of 1970, the corner points mentioned in lines 1 and 2 above were in conformance with regulations and rules therefore as required in the current manual of survey instructions of the United States Department of the Interior, Bureau of Land Management or by a decree of a Court of Law and /or that the corner points mentioned in lines 3, 4 and 5 above were in conformance with the rules of the Michigan Board of Land Surveyors or by a Decree of a Court of Law; established, re-established, monumented, recovered, found as expressed below:

NOTE: Not more than 2 corners, all in the same town and range, may be recorded on this certificate.

	A	B	C	D	E	F	G	H	I	J	K	L	M
1													
2		6		5		4		3		2		1	
3													
4		7		8		9		10		11		12	
5													
6		18		17		16		15		14		13	
7													
8		19		20		21		22		23		24	
9													
10		30		29		28		27		26		25	
11													
12		31		32		33		34		35		36	
13													

A. Description of original monument and accessories and/or subsequent restoration:

H-3 GLO Notes	1/2" Rod & Cap #15410
June 26, 1856	S35°E 6.75' 4" Oak
Set Quarter Section Post	N70°W 14.60' 3" Spruce
Aspen 10 N10W 10 Links	N08°W 7.60' 3" Spruce
Aspen 10 S40E 16 Links	N00°E 0.32' Fence Corner

B. Description of corner evidence found and/or method applied in restoring or reestablishing corner:

H-3 1/2" Rod & Cap #15410
At Fence corner
S35°E 6.75' 4" Oak
Due North 0.32' Fence Corner
N08°W 7.60' 3" Spruce
N70°W 14.60' 3" Spruce


SURVEY &
REMONUMENTATION

JAN 14 1999

SECTION

C. Description of monument for corner and accessories established to perpetuate locating the position of the corner:

H-3 1/2" Rod & Cap #15410
S35°E 6.75' 7" Oak
North 0.32' FE Corner
N08°W 7.60' 5" Spruce
N88°E 14.60' 3" Spruce
North 33.00' 1/2" Rod & Cap #33984

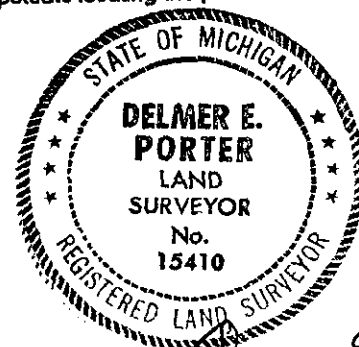

Ratified by Peer Group
in accordance with P.A. 345
Chairman Norman J. Quinn
Date 12/17/98

Signed by Delmer E. Porter
Surveyor's Michigan License No. #15410

Date Dec 9, 1998