

JAN 14 1999

SECTION 329 PAGE 591

1998 Presque Isle County State of Michigan Land Corner Remonumentation

LAND CORNER RECORDATION CERTIFICATE
Filing Requirement of Act 74, Mich. P.A. 1970

For corners in

Presque Isle County (County) Located In: Bismarck Corner Code #


1. Public Land Survey	T 34N R 4E	I-4
	T R	
	T R	
	T R	
2. Property Controlling In Section	S T R	
	S T R	
3. Miscellaneous Property in Sec.	S T R	
	S T R	

PRESQUE ISLE COUNTY
RECORDED
98 NOV 25 AM 11:13
Janet M. Lamb
REGISTER OF DEEDS
Register of Deeds Stamp & File Number

4. Lot No. , Recorded Plat
5. Private Claims

I, James A. Beck, in a field survey on August 18, 1998 do hereby state that under requirements of P.A. 74, Michigan P.A. of 1970, the corner points mentioned in lines 1 and 2 above were in conformance with regulations and rules therefore as required in the current manual of survey instructions of the United States Department of the Interior, Bureau of Land Management or by a decree of a Court of Law and for that the corner points mentioned in lines 3, 4 and 5 above were in conformance with the rules of the Michigan Board of Land Surveyors or by a Decree of a Court of Law; established, re-established, monumented, recovered, found as expressed below:

NOTE: Not more than 2 corners, all in the same town and range, may be recorded on this certificate.

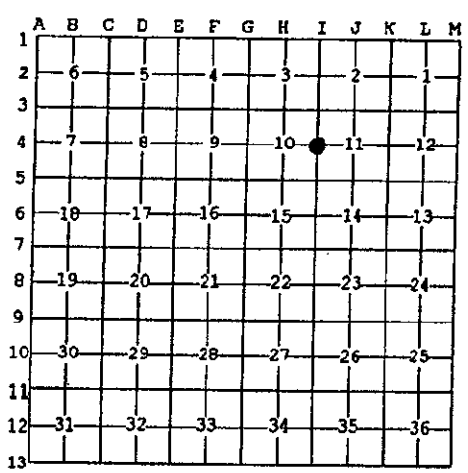

A. Description of original monument and accessories and/or subsequent restoration:
I-4 1856 G.L.O. by Alfred Millerd circa 1940
"Set 1/4 Sec. post"
B. Oak 12 N 30 W 10
W. Pine 30 S 45 E 30


by G.F. DeLaMater No. 2674 Volume Labeled
"Established Section Corners" on file in Preque
Isle County Register of Deeds Office.
1/2" x 48" bar in Corner
"Found 1 Gov't B & P"
Y. Pine 14 N36E 51.9
W. Pine 12 S16W 87.5

B. Description of corner evidence found and/or method applied in restoring or reestablishing corner:
I-4 Found 1/2" iron bar and 15410 cap at corner

Witnesses:
S 45°E 19.8', 36" W. Pine stump (remnants of original bearing tree)
N 36°E 52.87', 24" Yellow Pine (old witness) set P.S. 21559 tag

Ratified by Peer Group
in accordance with P.A. 345
Chairman Norman J. [Signature]
Date 7/2/98

C. Description of monument for corner and accessories established to perpetuate locating the position of the corner:
I-4 1/2" iron bar and 15410 cap at corner: Witnesses: S 45°E 19.8', 36" W. Pine stump (remnants of original bearing tree)
N 36°E 52.87', 24" Yellow Pine (old witness) set P.S. 21559 tag; N20°E 10.32' 16" Norway Pine, 15410 tag (found)
N 50°E 21.21' 16" Norway Pine, 15410 tag (found); S 18°E 64.12' 20" Norway Pine, 15410 tag (found)
S 17°E 23.70', 3" W. Pine, 15410 tag (found); S 24°W 88.04' 20" W. Pine, 21559 tag
Corner falls 19 feet Sly of 2 rut driveway, 38 feet Sly of single wire fence corner with fence running Westerly and Southerly, and 105' Westerly of 2 rut road running North and South.

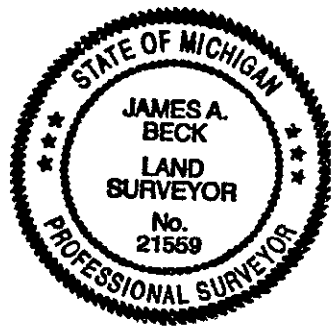

Signed by James A. Beck
Surveyor's Michigan License No. 21559

Date October 4, 1998