

2358

LIBER 329 PAGE 592

1998 Presque Isle County State of Michigan Land Corner Remonumentation

LAND CORNER RECORDATION CERTIFICATE
Filing Requirement of Act 74, Mich. P.A. 1970

For corners in

Presque Isle County
(County)Located in:
Bismarck

Corner Code #

1. Public Land Survey

T 34N R 4E

I-5

T R

T R

T R

T R

2. Property Controlling
in Section

S

T R

S

T R

3. Miscellaneous
Property in Sec.

S

T R

S

T R

PRESQUE ISLE COUNTY
RECORDED

98 NOV 25 AM 11:14

Jenit M. Lamb
REGISTER OF DEEDS

Register of Deeds Stamp & File Number

4. Lot No. _____ Recorded Plat _____

5. Private Claims _____

I, James A. Beck, in a field survey on August 18, 1998 do hereby state that under requirements of P.A. 74, Michigan P.A. of 1970, the corner points mentioned in lines 1 and 2 above were in conformance with regulations and rules therefore as required in the current manual of survey instructions of the United States Department of the Interior, Bureau of Land Management or by a decree of a Court of Law and/or that the corner points mentioned in lines 3, 4 and 5 above were in conformance with the rules of the Michigan Board of Land Surveyors or by a Decree of a Court of Law, established, re-established, monumented, recovered, found as expressed below:

NOTE: Not more than 2 corners, all in the same town and range, may be recorded on this certificate.

	A	B	C	D	E	F	G	H	I	J	K	L	M
1													
2	6		5			4		3		2		1	
3													
4	7		8			9		10		11		12	
5													
6	18		17			16		15		14		13	
7													
8	19		20			21		22		23		24	
9													
10	30		29			28		27		26		25	
11													
12	31		32			33		34		35		36	
13													

A. Description of original monument and accessories and/or subsequent restoration:
I-5 1856

SEE REVERSE SIDE OF FORM FOR CONTINUATION
OF SECTION "A."

G.L.O. by Alfred Millerd

"Set post Cor. of Secs. 10, 11, 14, & 15"

W. Pine 6 N20W 38

W. Birch 8 S15E 29

SURVEY &
REMONUMENTATION

JAN 14 1999

SECTION

B. Description of corner evidence found and/or method applied in restoring or reestablishing corner:
I-5 Found corner monument and witnesses as in February

27, 1997 recordation. (See reverse side "Continuation of Section "A"

Witnesses:

6" Tw. Maple N78°E 69.48'

4" W. Pine N77°W 51.69'

10" W. Birch S51°W 55.85'

2" Maple N17°E 62.44'

above witnesses have spikes set by Carl T. Kiiskila

Ratified by Peer Group
in accordance with P.A. 345

Chairman *William J. Bismarck*Date 7/2/98

C. Description of monument for corner and accessories established to perpetuate locating the position of the corner:
I-5 1 1/4" x 3/2" iron pipe w/cap

Witnesses:

6" Tw. Maple N78°E 69.48'

4" W. Pine N77°W 51.69'

10" W. Birch S51°W 55.85'

2" Maple N17°E 62.44'

above witnesses have spikes set by Carl T. Kiiskila


set 1 new witness

N 50°W 19.57', 3" J. Pine, 21559 tag

Signed by *James A. Beck*

Surveyor's Michigan License No. 21559

Date October 4, 1998

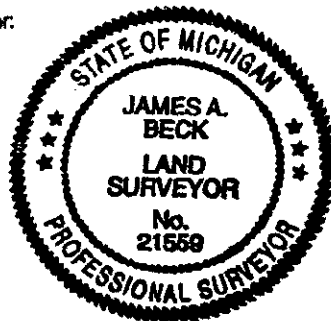

1998 Presque Isle County, State of Michigan

Remonumentation

Bismarck Township, T34N, R4E

Corner code: I-5 Corner Sections 10, 11, 14, & 15

Part "A": Continued

circa 1940 by G.F. DeLaMater No. 2674 Volume Labeled
 "Established Section Corners" on file in Presque
 Isle County Register of Deeds Office.
 " Found one Govt. B. and P."
 ½" x 48" bar in cor.
 W. Pine S 30 S59 1/2°E 82.1
 Y Pine S 20 S 61°W 56.9

March 20, 1981 P.A. 74 (Land Corner Recordation Certificate) by Delmer E. Porter
 No. 15410

Part A: of Certificate

½" Rod (DeLaMater 1944)

W. Pine Stump 30" S 59 1/2°E 82.1'

Y. Pine Stump 30" W61°W 56.9'

Part B: Found (same as above)

Part C: ½" Rod

N 73°E 69.54' Tw. Maple

S 47°W 55.92' 8" Birch

N 62°W 58.37' 5" Maple

February 27, 1997 P.A. 74 (Land Corner Recordation Certificate) by Carl T. Kiiskila No.
 33981

Part A: (of certificate)

(No evidence of G.L.O. corner, B.T's, line trees & topography
 as called out in the G.L.O. line notes; unless noted in item "B"
 below.)

Part B: Found and accepted a ½" rebar as witnessed by Delmar Porter
 RLS, found on page 563 of Presque Isle Co. L.C.R.C'S. Corner
 set by Delemater in 1944. The corner fits G.L.O. samp ties
 North, East and South well. East-West trail road is 90' South.

Part C: Found ½" rod-Porter, added 1 1/4" x 32" iron pipe w/cap &
 set carsonite post.

6" Tw. Maple N78°E 69.48'

4" W. Pine N77°W 51.69'

10" W. Birch S51°W 55.85'

2" Maple N17°E 62.44'

Fence corner (smooth wire N & E N05 W 32.3')