

2001

PRESQUE ISLE COUNTY
RECORDED

1998 PRESQUE ISLE COUNTY, STATE OF MICHIGAN REMONUMENTATION

98 OCT 13 PM 3:55

LAND CORNER RECORDATION CERTIFICATE
Filing Requirement of Act 74, Mich. P.A. 1970

Janet M. Lamb
REGISTER OF DEEDS

For corners in

Presque Isle Located in: Corner Code #
(County)
Bismarck Township
1. Public Land Survey T 34R 4E K-1
T R
T R
T R
T R
2. Property Controlling S T R
in Section S T R
3. Miscellaneous S T R
Property in Sec. S T R

Register of Deeds Stamp & File Number

4. Lot No. , Recorded Plat
5. Private Claims

I, Ronald Bischer, in a field survey on 6-23, 19 98 do hereby state that under requirements of P.A. 74, Michigan P.A. of 1970, the corner points mentioned in lines 1 and 2 above were in conformance with regulations and rules therefore as required in the current manual of survey instructions of the United States Department of the Interior, Bureau of Land Management or by a decree of a Court of Law and/or that the corner points mentioned in lines 3, 4 and 5 above were in conformance with the rules of the Michigan Board of Land Surveyors or by a Decree of a Court of Law, established, re-established, monumented, recovered, found as expressed below.

NOTE: Not more than 2 corners, all in the same town and range, may be recorded on this certificate.


| | A | B | C | D | E | F | G | H | I | J | K | L | M |
|----|---|----|---|----|---|----|---|----|---|----|---|----|---|
| 1 | | | | | | | | | | | | | |
| 2 | | 6 | | 5 | | 4 | | 3 | | 2 | | 1 | |
| 3 | | | | | | | | | | | | | |
| 4 | | 7 | | 8 | | 9 | | 10 | | 11 | | 12 | |
| 5 | | | | | | | | | | | | | |
| 6 | | 16 | | 17 | | 16 | | 15 | | 14 | | 13 | |
| 7 | | | | | | | | | | | | | |
| 8 | | 19 | | 20 | | 21 | | 22 | | 23 | | 24 | |
| 9 | | | | | | | | | | | | | |
| 10 | | 30 | | 29 | | 28 | | 27 | | 26 | | 25 | |
| 11 | | | | | | | | | | | | | |
| 12 | | 31 | | 32 | | 33 | | 34 | | 35 | | 36 | |
| 13 | | | | | | | | | | | | | |

A. Description of original monument and accessories and/or subsequent restoration:

K-1
1856 Alfred Millerd (Resurvey)
Set wood post and 4 witnesses
June 17, 1976 John Nelson #21273
set 5/8" rod from Scott witnesses
left 3 witnesses
June 20 1978 Delmer Porter #15410
found 5/8" rod raised with 1/2" rod left 3 witnesses

B. Description of corner evidence found and/or method applied in restoring or reestablishing corner:

K-1
found 1/2" rod 1' below asphalt, raised with
1/2" rod and cap #22428

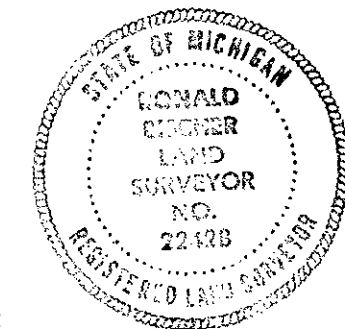

SURVEY &
REMONUMENTATION

JAN 14 1999

SECTION

C. Description of monument for corner and accessories established to perpetuate locating the position of the corner:

K-1
1/2" rod and cap #22428

S58°W 59.38' P. Pole (Bischer Witness)
S24°W 58.40' 18" Cedar (Nelson Witness)
S23°E 59.25' 9" Cedar (Nelson Witness)
N20°W 98.40' P. Pole (Nelson Witness)

Ratified by Peer Group
in accordance with P.A. 345

Chairman *William J. Quam*
Date 7/2/98

Signed by *Ronald R. Bischer*
Surveyor's Michigan License No. 22428

Date Sept. 28, 1998