

2007

1998 PRESQUE ISLE COUNTY, STATE OF MICHIGAN REMONUMENTATION

PRESQUE ISLE COUNTY
RECORDED

98 OCT 13 PM 3:56

James M. Lamb
REGISTER OF DEEDS

LAND CORNER RECORDATION CERTIFICATE
Filing Requirement of Act 74, Mich. P.A. 1970

For corners in

<u>Presque Isle</u> (County)	Located In:	Corner Code #
<u>Bismark Township</u>		
1. Public Land Survey	T <u>34</u> N R <u>4E</u>	<u>K-7</u>
	T <u> </u> R <u> </u>	<u> </u>
	T <u> </u> R <u> </u>	<u> </u>
	T <u> </u> R <u> </u>	<u> </u>
2. Property Controlling in Section	S <u> </u> T <u> </u> R <u> </u>	<u> </u>
	S <u> </u> T <u> </u> R <u> </u>	<u> </u>
3. Miscellaneous Property in Sec.	S <u> </u> T <u> </u> R <u> </u>	<u> </u>
	S <u> </u> T <u> </u> R <u> </u>	<u> </u>

Register of Deeds Stamp & File Number

4. Lot No. , Recorded Plat
5. Private Claims

I, Ronald Bischoer in a field survey on 6-3, 19 98 do hereby state that under requirements of P.A. 74, Michigan P.A. of 1970, the corner points mentioned in lines 1 and 2 above were in conformance with regulations and rules therefore as required in the current manual of survey instructions of the United States Department of the Interior, Bureau of Land Management or by a decree of a Court of Law and /or that the corner points mentioned in lines 3, 4 and 5 above were in conformance with the rules of the Michigan Board of Land Surveyors or by a Decree of a Court of Law; established, re-established, monumented, recovered, found as expressed below:


NOTE: Not more than 2 corners, all in the same town and range, may be recorded on this certificate.

	A	B	C	D	E	F	G	H	I	J	K	L	M
1													
2		6		5		4		3		2		1	
3													
4		7		8		9		10		11		12	
5													
6		18		17		16		15		14		13	
7													
8		19		20		21		22		23		24	
9													
10		30		29		28		27		26		25	
11													
12		31		32		33		34		35		36	
13													

A. Description of original monument and accessories and/or subsequent restoration:

K-7

1856 Alfred Millerd
Set wood post and 2 witnesses
March 12, 1981 Delmer Porter #15410
set 1/2" rod at old fence corner
left 3 witnesses

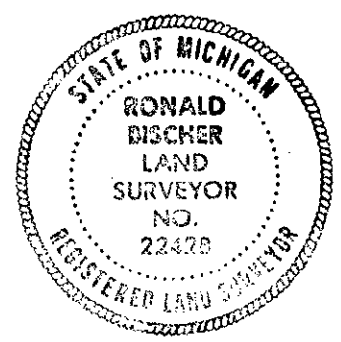

B. Description of corner evidence found and/or method applied in restoring or reestablishing corner:

K-7
found 1/2" rod and cap #15410

SURVEY &
REMONUMENTATION

JAN 14 1999

SECTION

C. Description of monument for corner and accessories established to perpetuate locating the position of the corner:

K-7
1/2" rod and cap #15410

S81°W 14.15' 5" Fir
N62°W 15.75' 13" Lynn
S34°E 36.35' 10" Cedar O.W.
N80°E 27.88' 6" Cedar O.W.

Ratified by Peer Group
in accordance with P.A. 345
Chairman *James M. Lamb*
Date 7/2/98

Signed by *Ronald R. Bischoer*
Surveyor's Michigan License No. 22428

Date Sept. 28, 1998