

DEC 29 1999

1999 PRESQUE ISLE COUNTY REMONUMENTATION

SECTION

LAND CORNER RECORDATION CERTIFICATE
Filing Requirement of Act 74, Mich. P.A. 1970

For corners in

Presque Isle
(County)

Located in:

Corner Code #

1. Public Land Survey

T34N R 4E

M.P. #6 ✓

T R

T R

T R

T R

2. Property Controlling
in Section

S

T R

S

T R

3. Miscellaneous
Property in Sec.

S

T R

S

T R

Recorded Dec. 16, 1999At 11:30 clock A.M.Janet M. Lamb
Reg. of Deeds, Presque Isle Co. MI

Register of Deeds Stamp & File Number

4. Lot No. _____, Recorded Plat _____

5. Private Claims _____

I, Ronald Bischer, in a field survey on Aug. 20, 1999 do hereby state that under requirements of P.A. 74, Michigan P.A. of 1970, the corner points mentioned in lines 1 and 2 above were in conformance with regulations and rules therefore as required in the current manual of survey instructions of the United States Department of the Interior, Bureau of Land Management or by a decree of a Court of Law and /or that the corner points mentioned in lines 3, 4 and 5 above were in conformance with the rules of the Michigan Board of Land Surveyors or by a Decree of a Court of Law; established, re-established, monumented, recovered, found as expressed below:

NOTE: Not more than 2 corners, all in the same town and range, may be recorded on this certificate.

	A	B	C	D	E	F	G	H	I	J	K	L
1												
2		6		5		4		3		2		1
3												
4		7		8		9		10		11		12
5												
6		18		17		16		15		14		13
7												
8		19		20		21		22		23		24
9												
10		30		29		28		27		26		25
11												
12		31		32		33		34		35		36
13												

A. Description of original monument and accessories and/or subsequent restoration:

M.P. #6

1856 GLO Notes

S20° E 27 lks 5" Maple

S10° W 6 lks 10" Aspen

1969 Delmer Porter #15410

Set conc. mon

NE cor of Lost Lake Estates

Subdivision

B. Description of corner evidence found and/or method applied in restoring or reestablishing corner:

M.P. #6

Aug. 20, 1999 Presque Isle County Remonumentation

Ronald Bischer #22428

found conc. mon.

set four witnesses

C. Description of monument for corner and accessories established to perpetuate locating the position of the corner:

M.P. #6

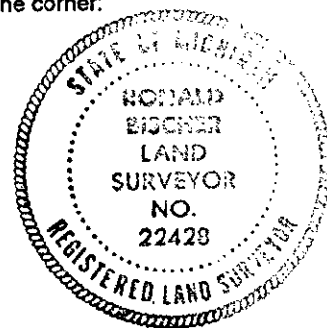
concrete monument

S59° W 4.02' 8" Maple

N14° E 5.68' 4" Maple

S45° E 30.43' 20" Norway

S71° E 6.25' 4" Maple

Ratified by Peer Group
in accordance with P.A. 345Chairman Norman J. OrsiniDate 11/30/99

Signed by Ronald E. Bischer
Surveyor's Michigan License No. 22428

Date 12-13-99