

RECORDED

1993

PRESQUE ISLE COUNTY
RECORDED

93 DEC 22 AM 10:00

COMMISSIONER

LAND CORNER RECORDATION CERTIFICATE
Filing Requirement of Act 74, Mich. P.A. 1970

James M. Lamb
REGISTER OF DEEDS

For corners in

PRESQUE ISLE	Located in:	Corner Code #
1. Public Land Survey	T <u>34</u> R <u>2E</u>	<u>A-11</u>
	T <u> </u> R <u> </u>	<u> </u>
	T <u> </u> R <u> </u>	<u> </u>
	T <u> </u> R <u> </u>	<u> </u>
2. Property Controlling	S <u> </u> T <u> </u> R <u> </u>	<u> </u>
in Section	S <u> </u> T <u> </u> R <u> </u>	<u> </u>
3. Miscellaneous	S <u> </u> T <u> </u> R <u> </u>	<u> </u>
Property in Sec.	S <u> </u> T <u> </u> R <u> </u>	<u> </u>

Register of Deeds Stamp & File Number

4. Lot No. , Recorded Plat
5. Private Claims

I, DELMER E. PORTER, a field survey on SEPT. 25, 19 93,
do hereby certify that under requirements of P.A. 74, Michigan P.A. of 1970, the corner points mentioned
in lines 1 and 2 above were in conformance with regulations and rules therefore as required in the
current manual of survey instructions of the United States Department of the Interior, Bureau of Land
Management or by a decree of a Court of Law and/or that the corner points mentioned in lines 3, 4 and 5
above were in conformance with the rules of the Michigan Board of Land Surveyors or by a Decree of a
Court of Law; established, re-established, monumented, re-monumented, recovered, found as
expressed below:

NOTE: Not more than 4 corners, all in the same town and range, may be recorded
on this certificate.

A. Description of original monument and accessories and/or subsequent restoration:

A-11 GLO NOTES
JUNE 2, 1840
CEDAR 36" S 11° W 4 lks.
HEMLOCK 24" N 53° W 16 lks.

A-11 SEPT. 28, 1978
P.A. 74 BY DELMER E. PORTER
PAGE 229 LAND CORNER RECORDS

WITNESSES

1" ROD
N 35° W 59.48' 13" MAPLE
S 10° W 49.82' 11" MAPLE
S 45° E 57.80' P. POLE

NOTE: COUNTY REMONUMENTATION RECC
INDICATE A CONCRETE MONUMENT WITH
BRASS CAP MAY HAVE BEEN LEFT AT
THIS TIME

B. Description of corner evidence found and/or method applied in restoring or reestablishing corner:


A -11
SEPT. 25, 1993
FOUND CONCRETE MONMUNT WITH BRASS CAP
S 22° W 49.72' 24" MAPLE
N 25° W 59.42' 24" MAPLE
S 45° E 51.80' P. POLE

Ratified by Peer Group
in accordance with P.A. 345

Chairman *Delmer E. Porter*
Date December 14, 1993

C. Description of monument for corner and accessories established to perpetuate locating the position of the corner:

A-11
CONCRETE MONUMENT WITH BRASS CAP
S 22° W 49.72' 24" MAPLE
N 25° W 59.42' 24" MAPLE
N 67° W 34.38' 6" W. PINE
N 32° W 78.59' 4" W. PINE
* NAILS AND TAGS 15410 USED ON WITNESSES
PORTER'S SURVEY, P.C.

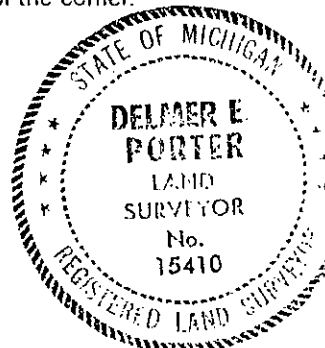

Signed by *Delmer E. Porter*

Date Dec 20, 1993

Surveyor's Michigan License No. 15410

CORNER HISTORY RESEARCH SHEET

A-11

T34N,R2E ALLIS TOWNSHIP-NORTH PART,
PRESQUE ISLE COUNTY, MICHIGAN.

ACTIVITY MONUMENT & ACCESSORIES - COMMENTS

GLO Survey
June 2, 1840

Cedar 36" S11°W 4 Links
Hemlock 24" N53°W 16 Links

Act 74 filing by:
Delmer E. Porter
#15410, Sept. 28, 1978,
Page 229, Corner
Recordation

Fd. 1" Rod in Road
Left Same
N35°W 59.48' 13" Maple
S10°W 49.82' 11" Maple
S45°E 51.80' P. Pole

Presque Isle
Remonumentation
Project

Act 132 Survey by:
Porter's Survey
June 4, 1986,
Survey#41-86,
File#34R2190, Recorded
Lib. ²³³ Pg. 267

Fd. Presque Isle Mon.
Conc. Mon. w/Brass Cap
Fd. Same Witness as above

Shown on Survey
as: W 1/4 Cor
of Sec. 30 in
error.

Mortgage Report
April 27, 1987
Survey #42-87
File#34R2190-M

Fd. Same as above
Left Same

Shown on report
as W 1/4 Corner
in error

Remonumentation
Sept 25, 1993

Fd. Presque Isle Remon.
Conc. Mon. w/Brass Cap
S22°W 49.72' 24" Maple (Old Witness)
N25°W 59.42' 24" Maple (Old Witness)
S45°E 51.80' P. Pole (Old Witness)
Left Same
S22°W 49.72' 24" Maple (Old Witness)
N25°W 59.42' 24" Maple (Old Witness)
N67°W 34.38' 6" W. Pine (Old Witness)
N32°E 78.59' 4" W. Pine (New Witness)

*Person's Data Does Not
Follow with Mon. To*

#3.

SURVEY &
MONUMENTATION

JAN 22 2001

SECTION