

PRESQUE ISLE COUNTY  
RECORDED

93 DEC 20 PM 4:50

LAND CORNER RECORDATION CERTIFICATE  
Filing Requirement of Act 74, Mich. P.A. 1970

For corners in

PRESQUE ISLE  
(County)

Located In:

Corner Code H-7

*Janet M. Lamb*  
REGISTER OF DEEDS

- |                                       |                          |            |
|---------------------------------------|--------------------------|------------|
| 1. Public Land Survey                 | T <u>34N</u> R <u>2E</u> | <u>H-7</u> |
|                                       | T _____ R _____          | _____      |
|                                       | T _____ R _____          | _____      |
|                                       | T _____ R _____          | _____      |
| 2. Property Controlling<br>in Section | S _____ T _____ R _____  | _____      |
|                                       | S _____ T _____ R _____  | _____      |
| 3. Miscellaneous<br>Property in Sec.  | S _____ T _____ R _____  | _____      |
|                                       | S _____ T _____ R _____  | _____      |

LIBER **307** PAGE **942**

Register of Deeds Stamp & File Number

4. Lot No. \_\_\_\_\_, Recorded Plat \_\_\_\_\_
5. Private Claims \_\_\_\_\_

I, Ronald R. Bischer, in a field survey on September 15, 19 93, do hereby certify that under requirements of P.A. 74, Michigan P.A. of 1970, the corner points mentioned in lines 1 and 2 above were in conformance with regulations and rules therefore as required in the current manual of survey instructions of the United States Department of the Interior, Bureau of Land Management or by a decree of a Court of Law and/or that the corner points mentioned in lines 3, 4 and 5 above were in conformance with the rules of the Michigan Board of Land Surveyors or by a Decree of a Court of Law; established, re-established, monumented, re-monumented, recovered, found as expressed below:

**NOTE: Not more than 4 corners, all in the same town and range, may be recorded on this certificate.**

	A	B	C	D	E	F	G	H	I	J	K	L	M
2	6		5		4		3		2				
3													
4	7		8		9		10		11		12		
5													
6	18		17		16		15		14		13		
7													
8	19		20		21		22		23		24		
9													
10	30		29		28		27		26		25		
11													
12	31		32		33		34		35		36		
13													

A. Description of original monument and accessories and/or subsequent restoration:

H-7

1855 Resurvey - Geo. H. Cannon (July)

Set Wood Post

11" Sugar S20°E 20 links

6" Beech N54°W 21 links

1975 - Delmar E. Porter

Set ½" Rod and Cap #15140

N43°30'E 54.18' Power pole

S59°E 97.04' 7" Ash

S04°W 39.18' Fence corner

Recorded on Page 84, Land

Recordation, August 18, 1975.

B. Description of corner evidence found and/or method applied in restoring or reestablishing corner:

H-7

Found ½" Rod and Cap #15140

N40°E 54.18' Power pole


S62°E 97.04' 7" Ash

Due S 39.18' Fence corner

SURVEY &  
REMONUMENTATION

1993

COMMISSION

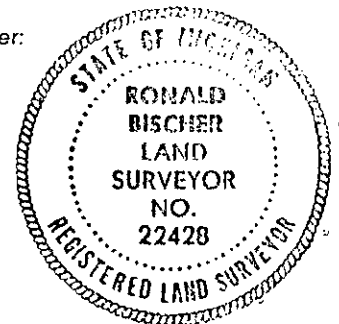

C. Description of monument for corner and accessories established to perpetuate locating the position of the corner:

H-7

½" Rod and Cap #15410

N40°E 54.18' Power pole

S62°E 97.04' 7" Ash

Due S 39.18' Fence corner

N76°E 97.38' 6" Apple tree

\*Witness tags and nails used.

Ratified by Peer Group

in accordance with P.A. 345

Chairman *Delmar E. Porter*

Date December 7, 1993

Signed by Ronald R. Bischer

Date 12-13-93

Surveyor's Michigan License No. 22428

## CORNER HISTORY RESEARCH SHEET

LIBER 307 PAGE 943

H-7 Corner, Section 15, 22, Township 34N Range 2E

<u>Activity</u>	<u>Monument &amp; Accessories</u>	<u>Notes</u>
1855 Resurvey Geo. H. Cannon	Set Wood Post 11" Sugar S20 E 20 links 6" Beech N54 W 21 links	
1975 Delmar E. Porter #15410	Set ½" Rod & Cap #15410 Set three witnesses. Recorded on Page 84, Land Recordation, August 18, 1975.	Set corner in line with fence line to North & South in road centerline.
1993 Remonumentation Ronald R. Bischer #22428	Found ½" Rod & Cap #15410 N40°E 54.18' Power pole found nail w/tag #15410 S62°E 97.04' 7" Ash found nail w/tag #15410 South 39.18' Fence corner found nail w/tag #15410 N76°E 97.38' 6" Apple Tree set nail w/tag #22428	

55