

LAND CORNER RECORDATION CERTIFICATE
Filing Requirement of Act 74, Mich. P.A. 1970

For corners in
Presque Isle
(County)

Located In:

Corner Code #

1. Public Land Survey T 34N R 5E D-11
 T R
 T R
 T R
2. Property Controlling S T R
 in Section S T R
3. Miscellaneous S T R
 Property in Section S T R
4. Lot No. _____, Recorded Plat _____
5. Private Claims _____

PRESQUE ISLE COUNTY
RECORDED

96 JUN 13 PM 12:24

Gene M. Lamb
REGISTER OF DEEDS

Register of Deeds Stamp & File Number

I, Ronald Bischer, in a field survey on 3-12, 19 96,
do hereby certify that under requirements of P.A. 74, Michigan P.A. of 1970, the corner points mentioned
in lines 1 and 2 above were in conformance with regulations and rules therefore as required in the current
manual of survey instructions of the United States Department of the Interior, Bureau of Land
Management or by a decree of a Court of Law and/or that the corner points mentioned in lines 3, 4 and
5 above were in conformance with the rules of the Michigan Board of Professional Surveyors or by a
Decree of a Court of Law; established, re-established, monumented, re-monumented, recovered, found
as expressed below:

NOTE: Not more than 4 corners, all in the same town and range, may be recorded
on this certificate.

	A	B	C	D	E	F	G	H	I	J	K	L	M
2	6		5		4		3		2		1		
3													
4	7		8		9		10		11		12		
5													
6	18		17		16		15		14		13		
7													
8	19		20		21		22		23		24		
9													
10	30		29		28		27		26		25		
11													
12	31		32		33		34		35		36		
13													


A. Description of original monument and accessories and/or subsequent restoration:

D-11
1856 Alfred Millend Set Wood Post
N50°W 26 links 8" Sugar
S53°E 9 links 6" Hemlock

5-22-78 Delmar Porter Found 3/4" Rod (Scott), badly bent,
replaced with 1/2" rod

B. Description of corner evidence found and/or method applied in restoring or reestablishing corner:

D-11
3-12-96 Ronald Bischer found 1/2" rod, set cap #22428
S27°W 56.15' P. pole
S33°E 52.00' Guy Pole

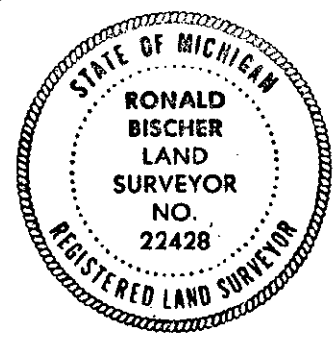

C. Description of monument for corner and accessories established to perpetuate locating the position of the corner:

D-11
3-12-96 Ronald Bischer
1/2" Rod & Cap #22428
S27°W 56.15' Power pole
S33°E 52.00' Guy pole
N33°E 34.17' 4" Elm
N72°E 71.16' 9" Elm

Ratified by Peer Group
in accordance with P.A. 345
Chairman *Delmar Porter*
Date 6/12/96

Signed by Ronald R. Bischer

Date 6-6-96

Surveyor's Michigan License No. 22428