

1996 PRESQUE ISLE COUNTY, STATE OF MICHIGAN REMONUMENTATION

LAND CORNER RECORDATION CERTIFICATE
Filing Requirement of Act 74, Mich. P.A. 1970

For corners in

Presque Isle
(County)

Located in:

Corner Code #

1. Public Land Survey

T 34N R 5E

F-1

2. Property Controlling
in Section

S

T

R

3. Miscellaneous
Property in Sec.

S

T

R

S

T

R

PRESQUE ISLE COUNTY
RECORDED

96 JUL 12 AM 11:38

Janet M. Sand
REGISTER OF DEEDS

Register of Deeds Stamp & File Number

4. Lot No. _____, Recorded Plat _____

5. Private Claims _____

I, James A. Beck, in a field survey on Jan 23, 1996 do hereby state that under requirements of P.A. 74, Michigan P.A. of 1970, the corner points mentioned in lines 1 and 2 above were in conformance with regulations and rules therefore as required in the current manual of survey instructions of the United States Department of the Interior, Bureau of Land Management or by a decree of a Court of Law and /or that the corner points mentioned in lines 3, 4 and 5 above were in conformance with the rules of the Michigan Board of Land Surveyors or by a Decree of a Court of Law; established, re-established, monumented, recovered, found as expressed below:

NOTE: Not more than 2 corners, all in the same town and range, may be recorded on this certificate.

	A	B	C	D	E	F	G	H	I	J	K	L	M
1													
2	6			5		4		3		2		1	
3													
4	7			8		9		10		11		12	
5													
6	18			17		16		15		14		13	
7													
8	19			20		21		22		23		24	
9													
10	30			29		28		27		26		25	
11													
12	31			32		33		34		35		36	
13													

A. Description of original monument and accessories and/or subsequent restoration:

F-1

G.L.O.
John Hodgson 1840
"Set 1/4 Section post"
Beech 7 N73W 43
do 7 N17E 6

Alfred Milerd 1856
("examination of South
Boundary of T35N of
Range 5 East")
no mention of corner
monument or witnesses

Sep. 25, 1978 1/2" rod and cap in Mon. Box
P.A. 74 Recordation Witnesses:
by Delmer Porter N 10°W 41.33' 26" Maple
Reg. No. 15410 N 66°E 89.49' 14" Maple
recording refers to
"P.K. Noll (Scott 1970)
N10°W 41.85' 26" Maple
N 45°W 64.33' 20" Maple"

P.A. 132 Recordation 1/2" rod and cap in Mon. Box
by Delmer Porter R.L.S.15410 Witnesses:
Recorded in Liber 226, N66°E 89.49' 14" Maple
Page 483 N 10°W 41.33' 26" Maple

B. Description of corner evidence found and/or method applied in restoring or reestablishing corner:

F-1

1996 Remonumentation
by James A. Beck

found 1/2" iron rod and 15410 cap in monument box
N 66°E 89.49' 20" Maple
N 46°E 68.3' 15410 tag in 20" Maple

Ratified by Peer Group
in accordance with P.A. 345

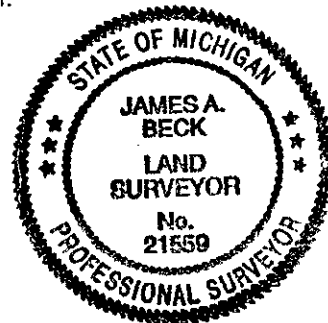
Chairman *Delmer Porter*Date 5/22/96

C. Description of monument for corner and accessories established to perpetuate locating the position of the corner:

F-1

1996 Remonumentation
by James A. Beck

1/2" iron rod and 15410 cap in monument box
N 66°E 89.49' 21559 tag in 20" Maple
N 46°E 68.3' 15410 tag in 20" Maple
S 73°W 122.30' 21559 tag in 14" Spruce
S 84°W 150.21' 21559 tag in power pole

Signed by *James A. Beck*Date June 17, 1996Surveyor's Michigan License No. 21559